


T.2S.R.3E.W.M.

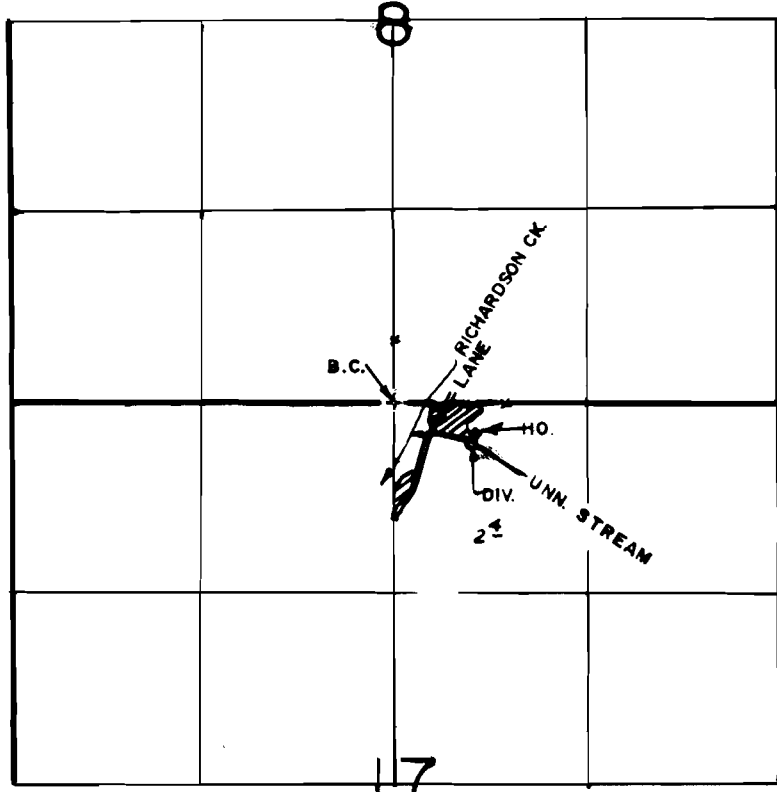

DIV. PT. LOC.: 280'S. & 520'E. FROM N. 1/4 COR. SEC. 17

**FINAL PROOF SURVEY**  
UNDER

Application No. 53342.. Permit No. 39576.....  
IN NAME OF

.....**JAMES MITUNIEWICZ**.....

Surveyed **MAR. 25. 19.80.**, by **R.G. MUCKEN**.....