


T. 38&4S. R.I.E. W.M.

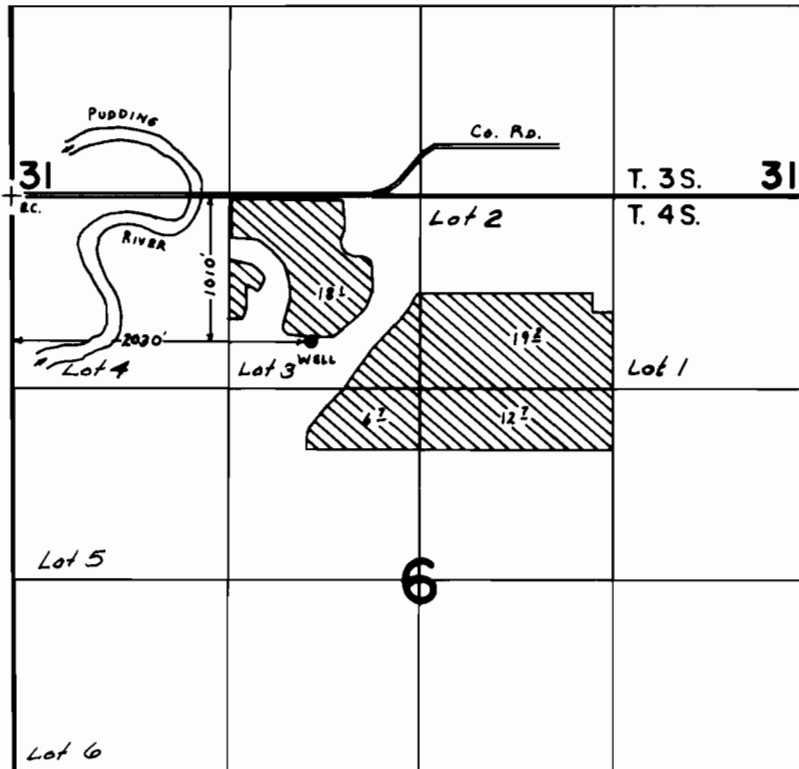

FINAL PROOF SURVEY UNDER

Application No. G-5728 Permit No. G-5528....
IN NAME OF

HAROLD E. CULP

Surveyed April 27 1979, by C. L. HUGHES....