


T.5S.,R.1E.,W.M.

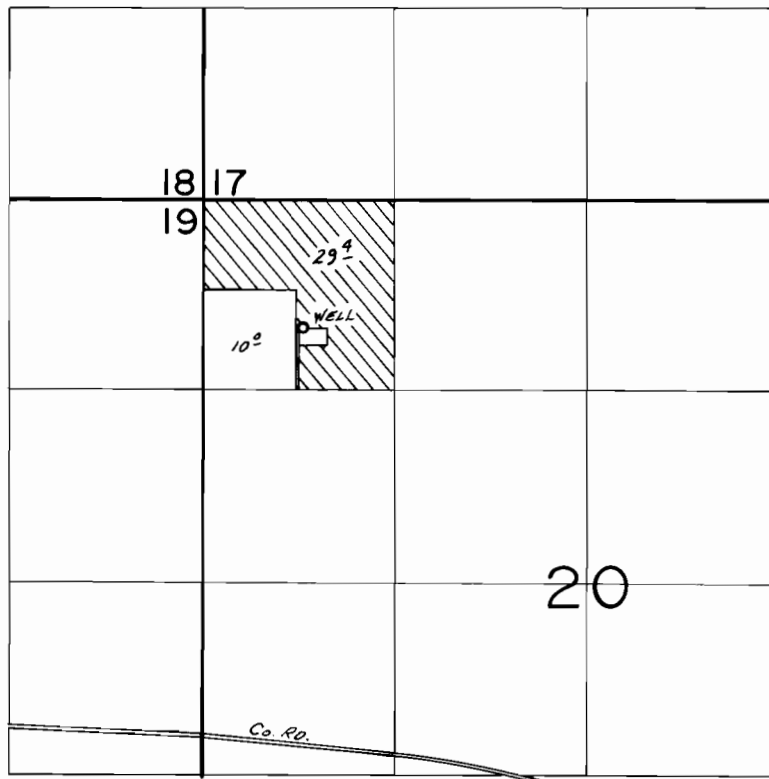

WELL LOC: 880'S. & 690'E. FROM NW COR. SEC. 20

SCALE: 1"=1320'

FINAL PROOF SURVEY UNDER

Application No. G-6551. Permit No. G-6155.....
IN NAME OF

ZOTIK KOSHKAROFF

Surveyed Aug. 8, 1984, by J.R. WOODROOF.