


T. 6N., R. 6W., W. M.

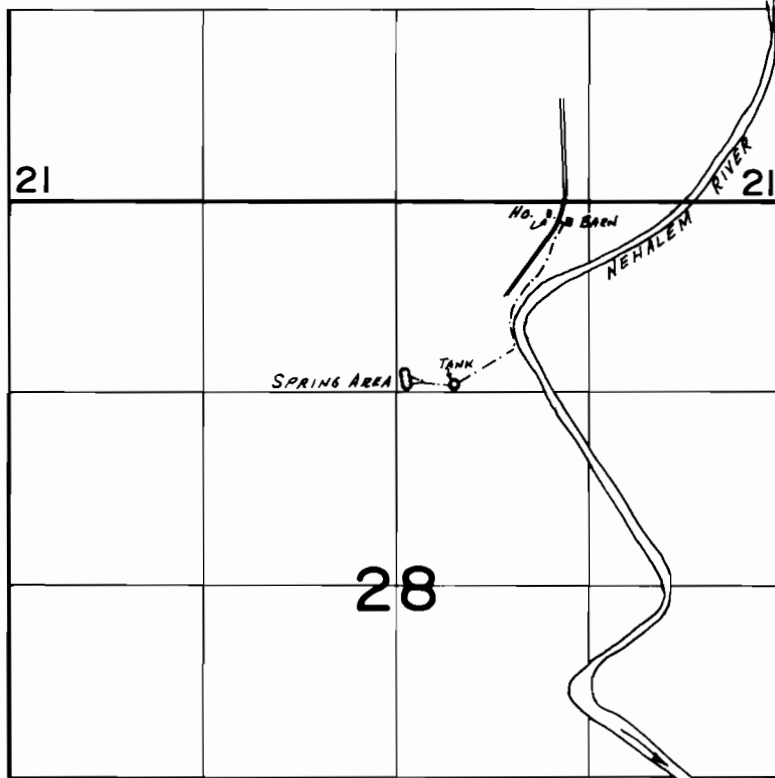

SPRING AREA LOC: 1270' S. & 50' E. FROM N<sup>1</sup>/<sub>4</sub> COR. SEC. 28.

SCALE: 1" = 1320'

**FINAL PROOF SURVEY**  
UNDER

Application No. 57908. Permit No. 43607.....  
IN NAME OF

**ROBERT B. & BYRNECE SPRAGUE**

Surveyed July 9, 1984, by B.W. BISHOP.....