

RECEIVED


JUL 9 1980

WATER RESOURCES DEPT.
SALEM, OREGON

RECEIVED
AUG 2 1972
STATE ENGINEER
SALEM, OREGON

APR 5 1972
STATE ENGINEER
SALEM, OREGON


BOB MOORE
SEC 24, T5N, R7W
SCALE 1" = 200'

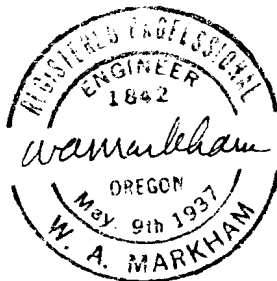

SURVEYOR'S CERTIFICATE:

I, Wilbur A. Markham, Registered Engineer No. 1842, hereby certify that this map is made from notes of an actual survey made by me on March 21, 1972.

W. A. Markham

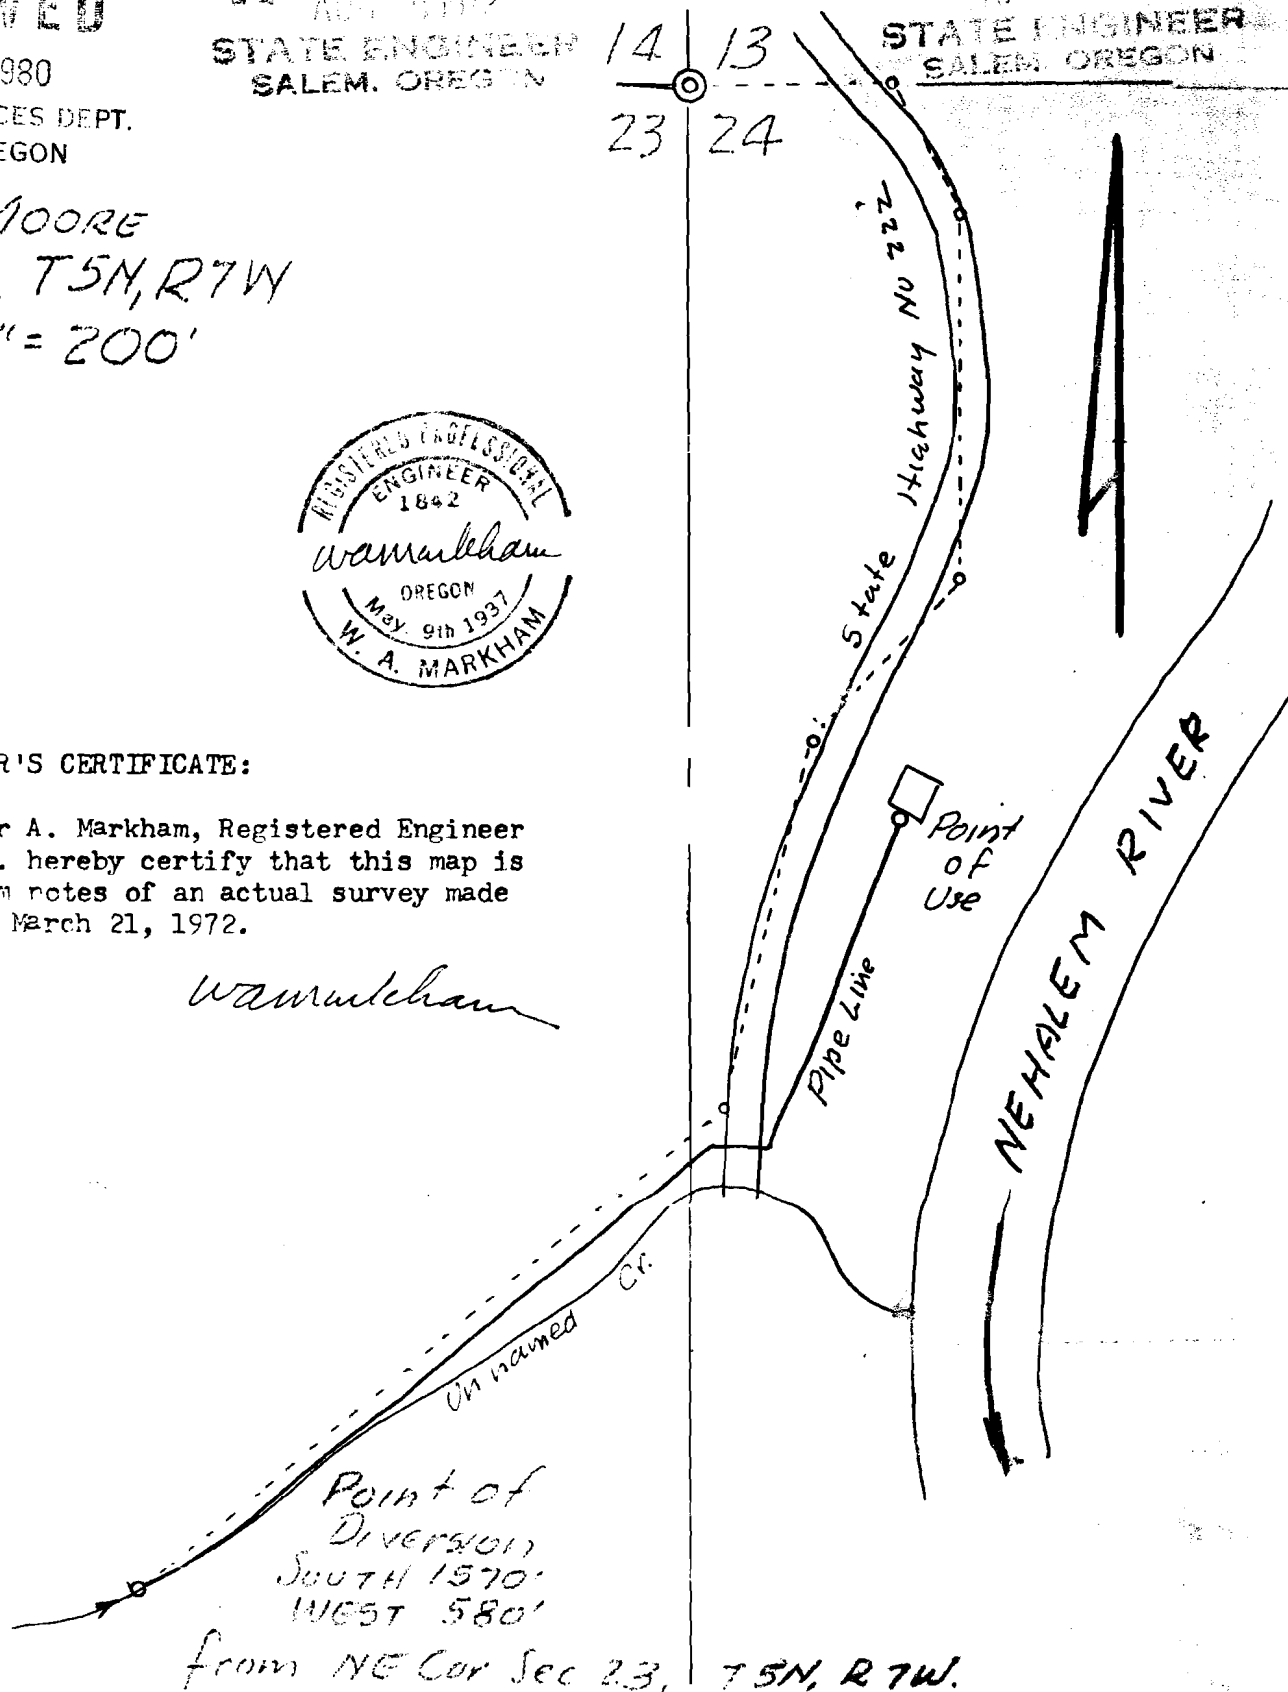

Application No. 60336
Permit No. 44949

Application No. 49129
Permit No. 36780