


T.27S. R.13W. W.M.

Sec. 2

NE 1/4

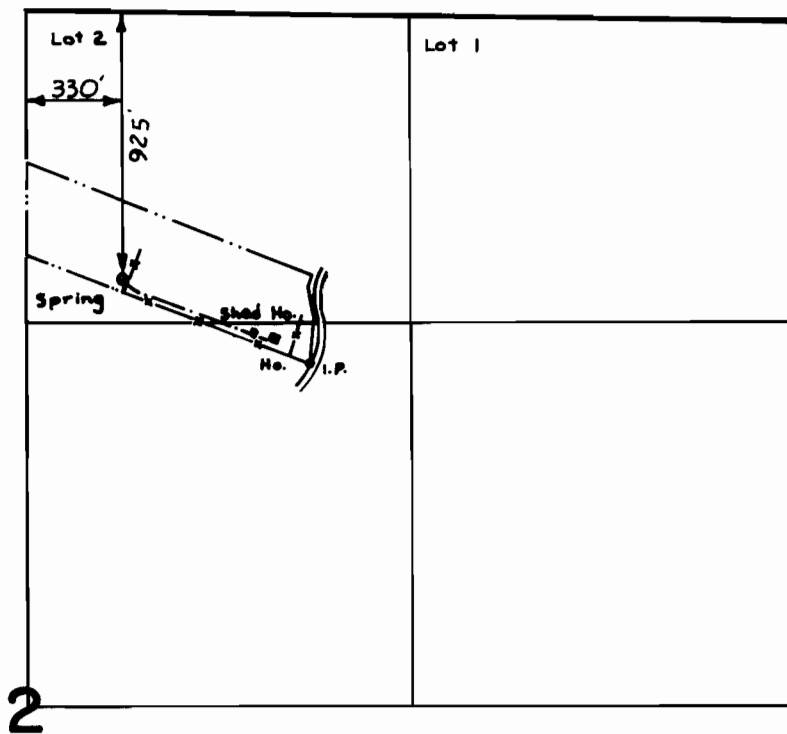

SCALE : 1" = 660'

FINAL PROOF SURVEY
UNDER

Application No. 54773 Permit No. 41097
IN NAME OF

FREDDIE LEE SICHTING

Surveyed April 18 1978, by B. Sund

Handwritten mark