


T. 28 S., R. 12 W., W. M.

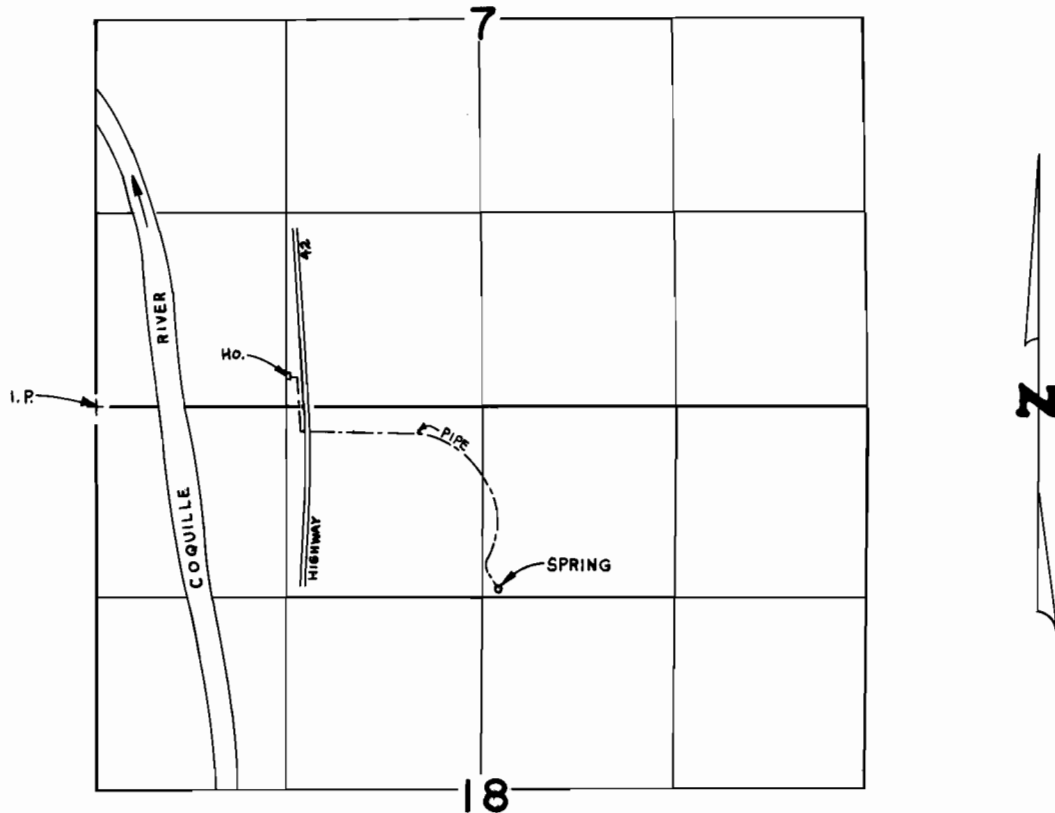

SPRING LOCATED 1,250' S. & 105' E. FROM N. 1/4 COR. SEC. 18

SCALE: 4" = 1 mile

FINAL PROOF SURVEY
UNDER

Application No. 63743... Permit No. 46903...
IN NAME OF

IRVIN C. & ALICE V. CAUDILL

Surveyed OCT. 18, 1983, by L. CASHION...