


T. 28 S., R. 12 W., W. M.

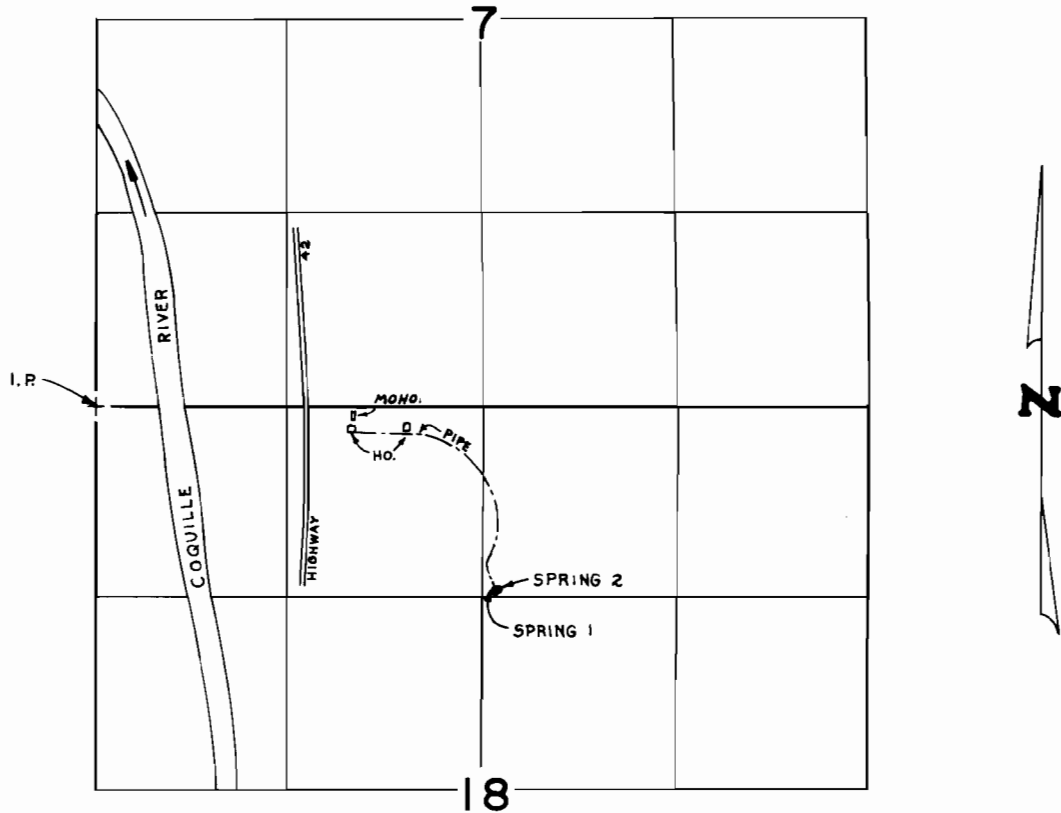

SPRING 1 LOCATED 1,260' S. & 80' E. FROM N. 1/4 COR. SEC. 18
SPRING 2 LOCATED 1,250' S. & 105' E. FROM N. 1/4 COR. SEC. 18

SCALE: 4" = 1 mile

FINAL PROOF SURVEY UNDER

Application No. 63756... Permit No. 47308...
IN NAME OF

RICHARD L. BRUGNOLI

Surveyed OCT. 18, 1983, by L. CASHION...