


T. 30 S., R. 3 W., W.M.

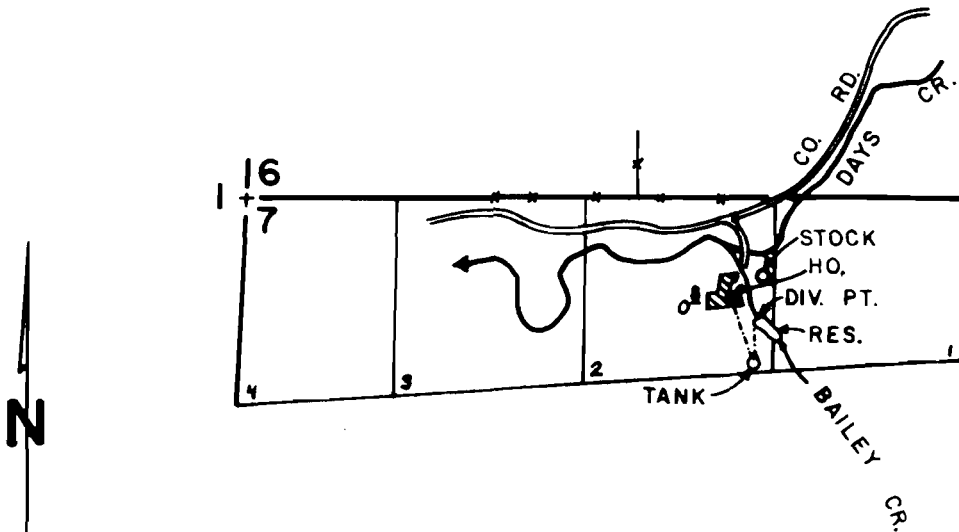

DIV. PT. LOCATED 840' S. and 3500' E. of NW CORNER Sec. 7

SCALE: 4" = 1 mile

FINAL PROOF SURVEY UNDER

R-53504 R-6425
Application No. 53505 Permit No. 40320.....
IN NAME OF

James R. Hilderbrand.....

Surveyed AUG. 24 1983., by J.S. DONALDSON