


T.29S., R.6W., W.M.

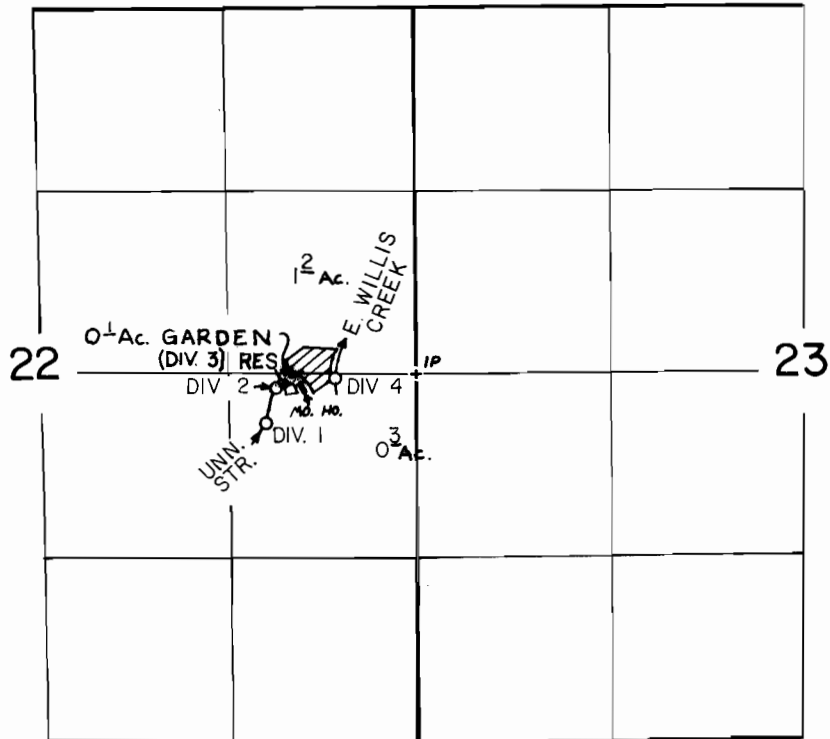

DIV 1 LOCATED	340' S.	&	1030' W.	
DIV 2 LOCATED	100' S.	&	960' W.	ALL FROM E. 1/4
DIV 3 LOCATED	110' S.	&	860' W.	COR. SEC. 22
DIV 4 LOCATED	30' S.	&	550' W.	

SCALE: 4" = 1 mile

FINAL PROOF SURVEY UNDER

R-57929	R-7801
57930	43949

Application No. 65889 Permit No. 48027.....

IN NAME OF

ROBERT ROSS TRAUTMAN

Surveyed JAN. 25, 1984, by J.E. Cashion
JULY 11, 1984