


T.29S., R.6W., W.M.

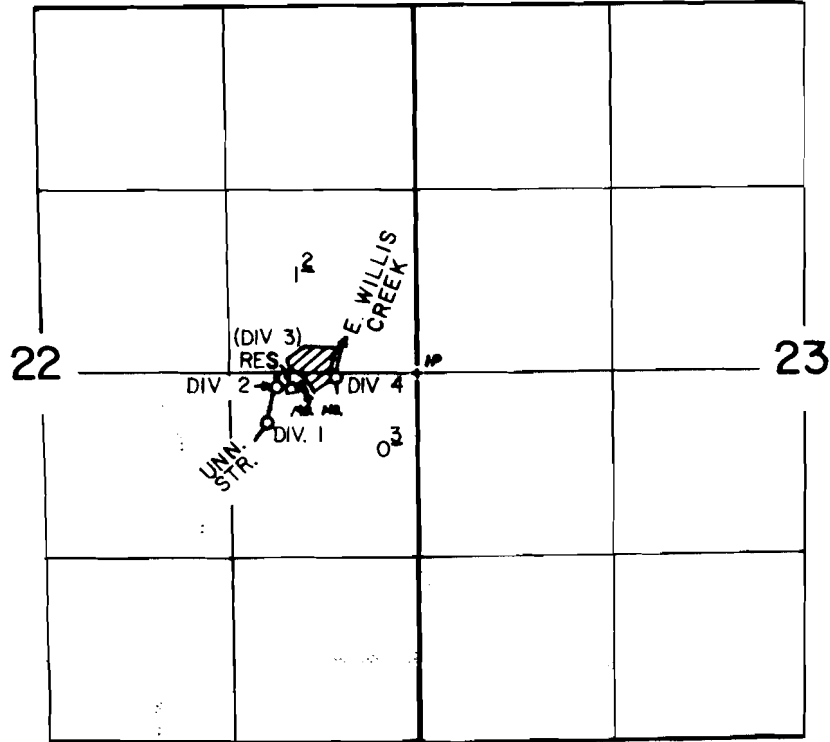

DIV 1 LOCATED 340' S. & 1030' W.
DIV 2 LOCATED 100' S. & 960' W.
DIV 3 LOCATED 110' S. & 860' W.
DIV 4 LOCATED 30' S. & 550' W.

ALL FROM E. 1/4
COR. SEC. 22

SCALE: 4" = 1 mile

FINAL PROOF SURVEY
UNDER

R-57929 R-7801
57930 43949

Application No. 65889 Permit No. 48027.....
IN NAME OF

ROBERT ROSS TRAUTMAN

Surveyed JAN. 25, 1984, by L.E. Cashion.....
JULY 11, 1984