


P-38941
53047

T.13S.,R.32E.,W.M.

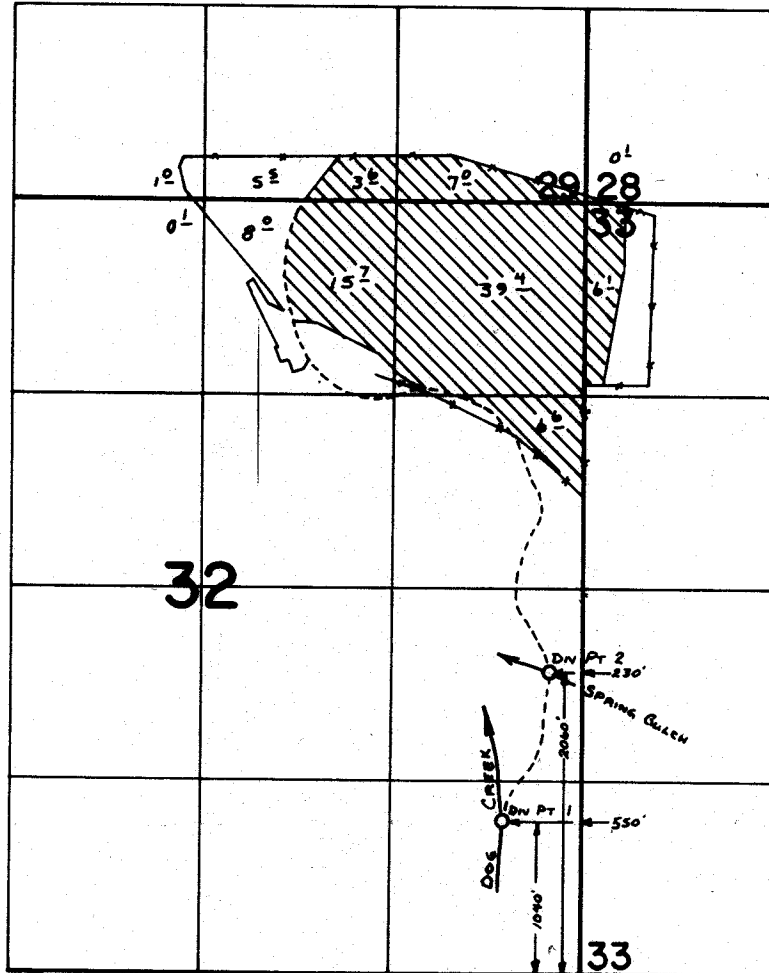

FINAL PROOF SURVEY
UNDER

Application No. 51640... Permit No. 38941.....

IN NAME OF

ESTATE OF
.....CHESTER O. ELLIOTT.....

Surveyed July 20, 1983, by R. W. Cettel.....