


P-43451 53948

T.14S., R.32E., W.M.

SECTION 1 & 12

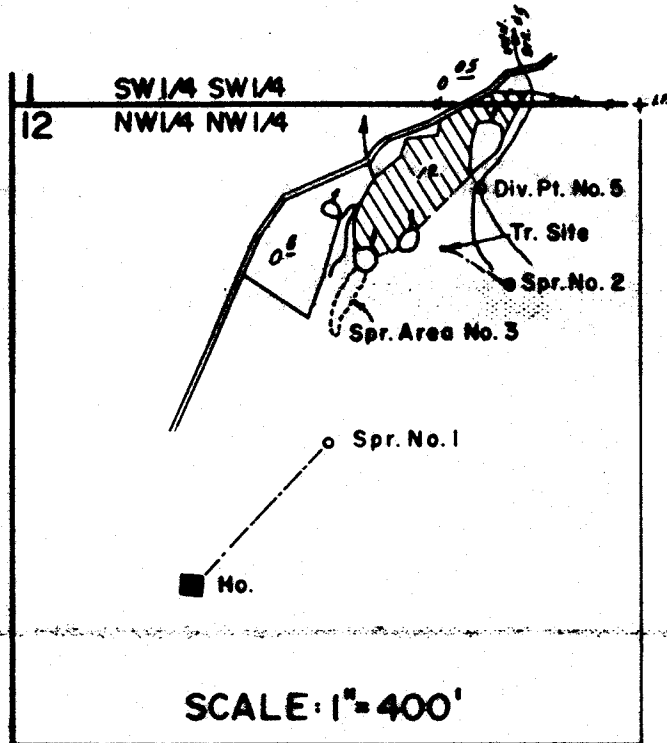

Spring No. 1: 670' S. & 660' W.
 Spring No. 2: 370' S. & 280' W.
 Spring Area No. 3: 420' S. & 630' W.
 Div. Pt. No. 5: 270' S. & 340' W.
 ALL from the NE corner NW 1/4 NW 1/4 Section 12

FINAL PROOF SURVEY UNDER

Application No. 557.37... Permit No. 43451.....
 IN NAME OF

.....HOWARD GEIGER.....

Surveyed July 29... 1983, by R.W. Cattel.....