


# T.26S.,R.34E.,W.M.

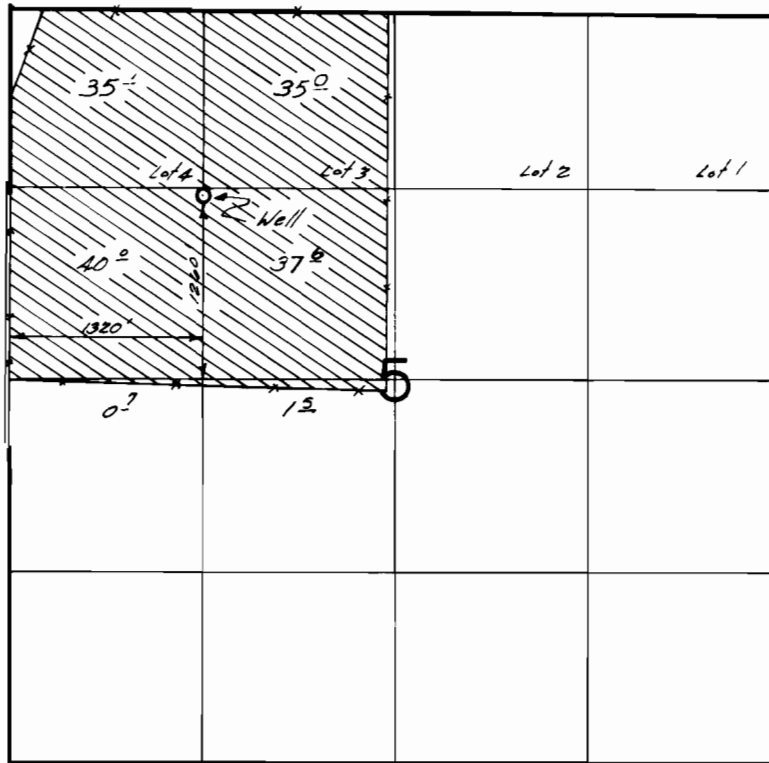

## FINAL PROOF SURVEY UNDER

Application No. G-8020 Permit No. G-7543  
IN NAME OF

Connecticut General Life Ins. Co.

Surveyed AUG. 26, 1979, by R.G. MUCKEN