


T.39S. R.3W. W.M.

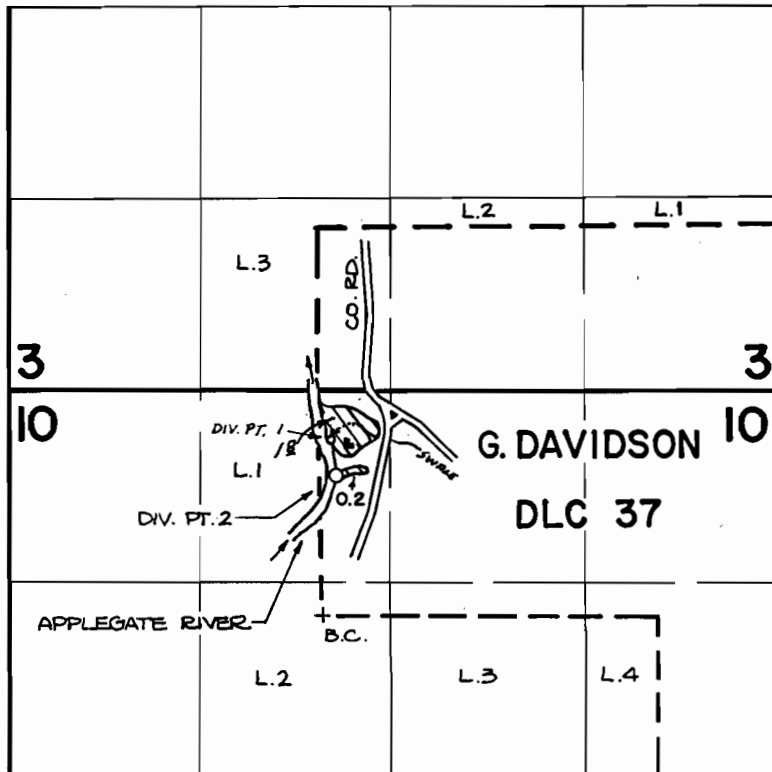

DIV. PT. #1 IS LOCATED 350'S. AND 350'W.; DIV. PT. #2 IS
LOCATED 500'S. AND 350'W.; BOTH FROM THE N. 1/4 OF SECTION 10.

FINAL PROOF SURVEY UNDER

Application No. 55990 Permit No. 42214....
IN NAME OF

BEN GERWICK, JR. & MARTELLE GERWICK

Surveyed MAY 18, 1982, by B. SUND....