


T.33S., R.6W., W.M.

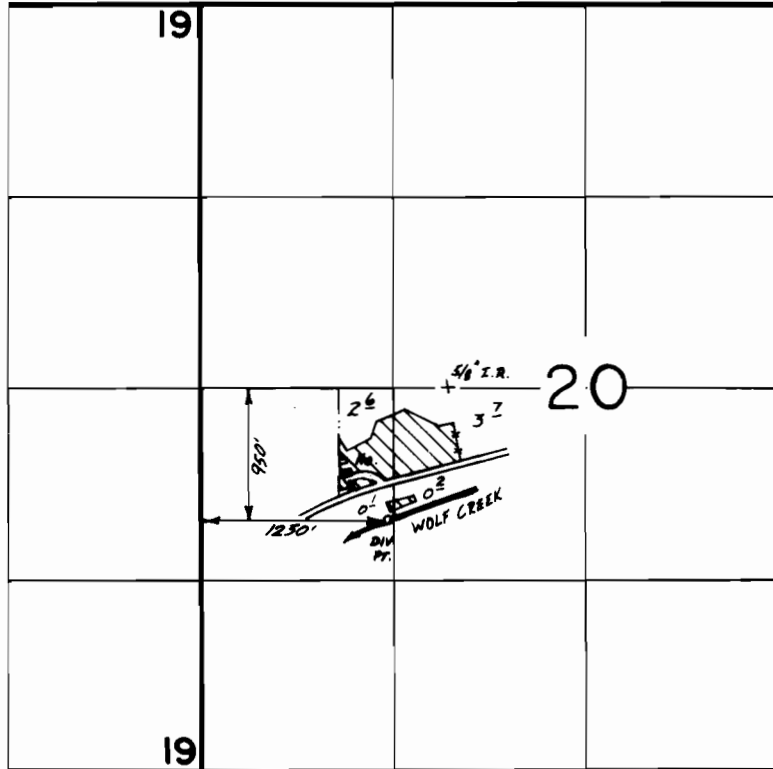

Scale 1"=1320'

**FINAL PROOF SURVEY**  
UNDER

Application No. 47152. Permit No. 35301.....  
IN NAME OF

....BARBARA.....L.....LEVERING.....

Surveyed Oct. 16, 1978, by B.R. SUND.....