


53053

Maurice

110 NW Wilmington

97201 T.25S.,R.18E.,W.M.

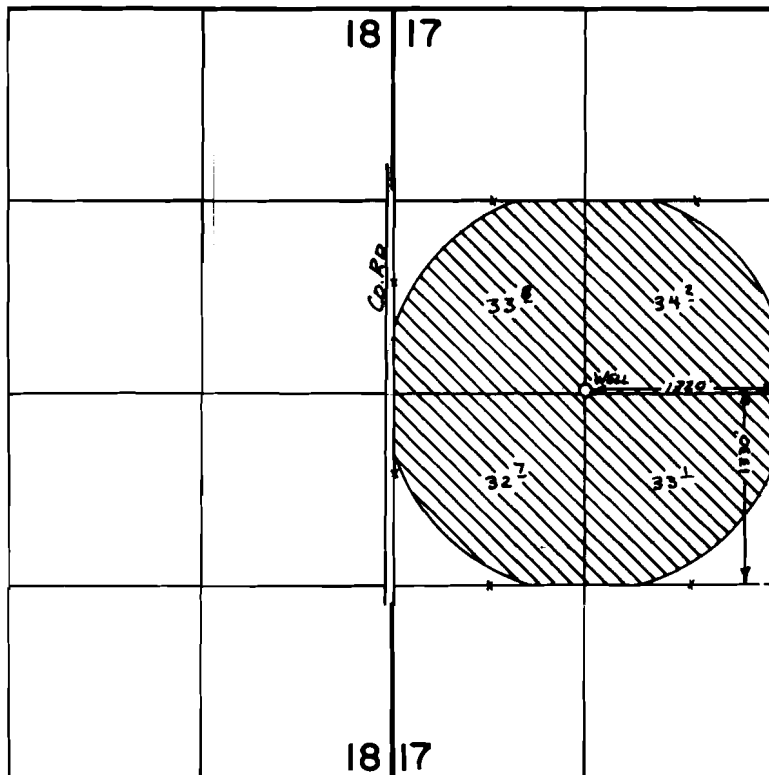

FINAL PROOF SURVEY

UNDER

Application No. G-9419, Permit No. G-8778.....
IN NAME OF

WADE C. BROWN

Surveyed July 21.... 1983., by L.M.TOLL.....