


G8981
53054

T.27S., R.16E., W.M.

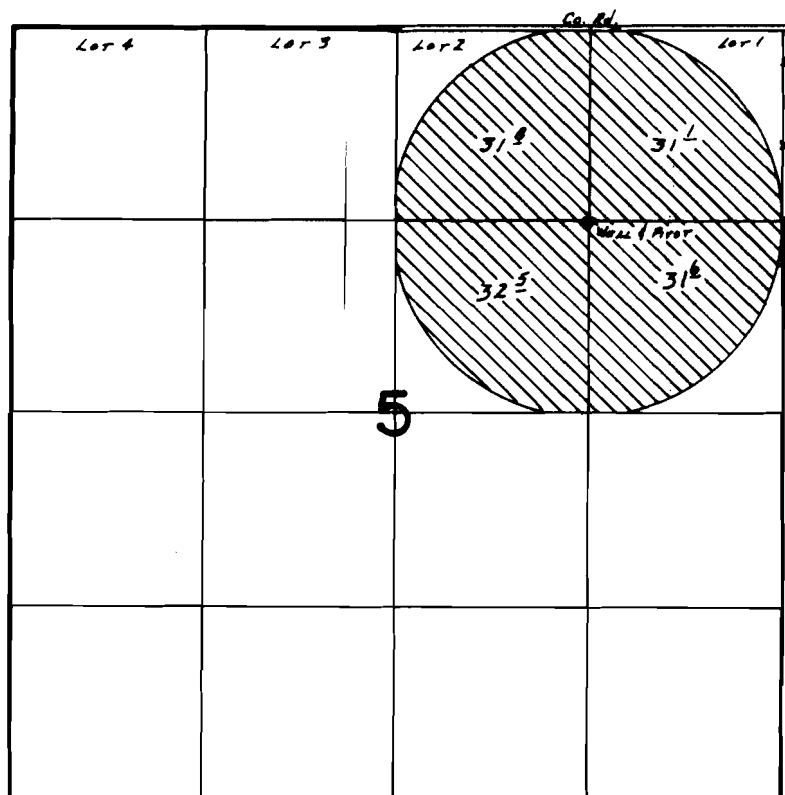

WELL LOC: 1330 S. & 1330 W. FROM NE COR. SEC. 5

SCALE: 1" = 1320'

FINAL PROOF SURVEY

UNDER

Application No. G-9548. Permit No. G-8981.....
IN NAME OF

.....GERALD L. LANIER.....

Surveyed OCT. 30.. 1984., by B.W. BISHOP.....