


G9171
53056

T.27S.,R.16E.,W.M.

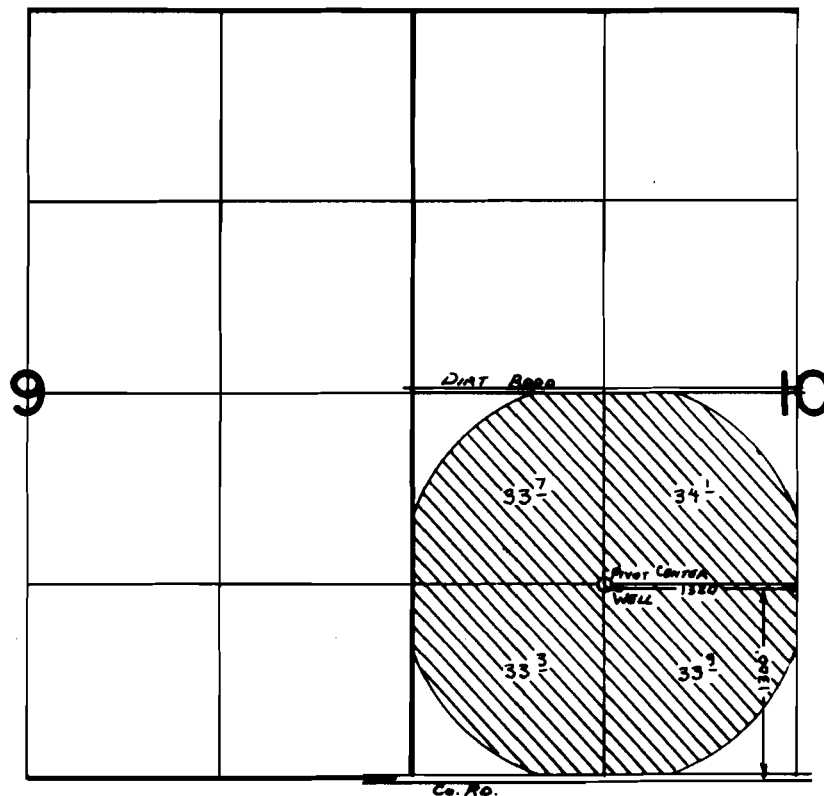

FINAL PROOF SURVEY
UNDER

Application No. G-10099. Permit No. G-9171.....
IN NAME OF

JIM ROBEY, Jr.

Surveyed July 25, 1983, by L. M. TOLL.....