


G 9294
53057

T. 24S., R. 18E., W. M.



PIVOT WELL LOC: 1350' S. & 2640' E. FROM NW COR. SEC. 33.
PAINTER WELL LOC: 1070' S. & 1610' E. FROM NW COR. SEC. 33

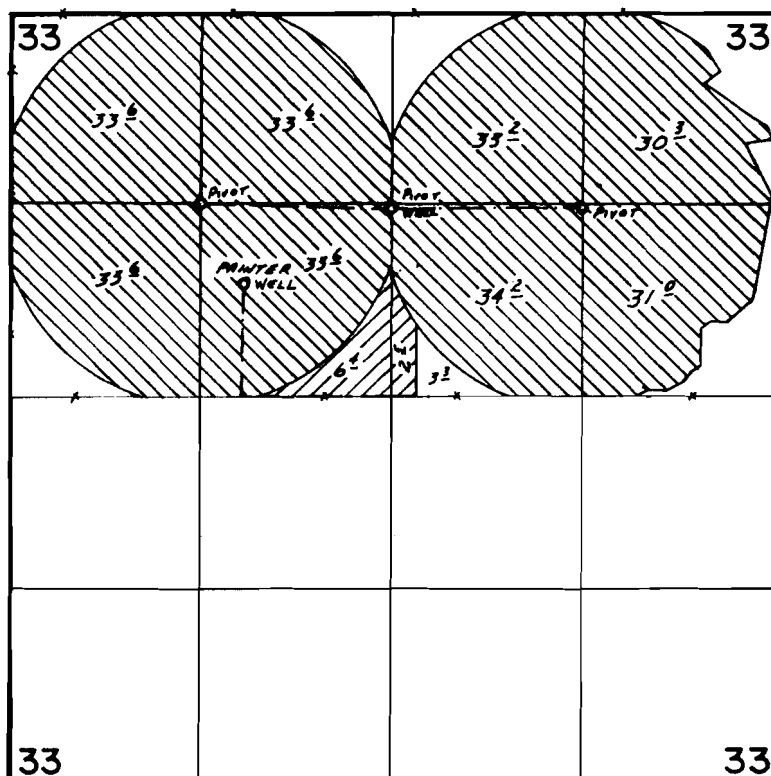

PIVOT WELL

PAINTER WELL

SCALE: 1" = 1320'

FINAL PROOF SURVEY UNDER

Application No. G-10253 Permit No. G-9294.....
IN NAME OF

.....960 RANCH INC.....

Surveyed OCT. 15, 1984, by R.W. BISHOP.....