


G 10035
53058

T. 27S., R. 17E., W.M.

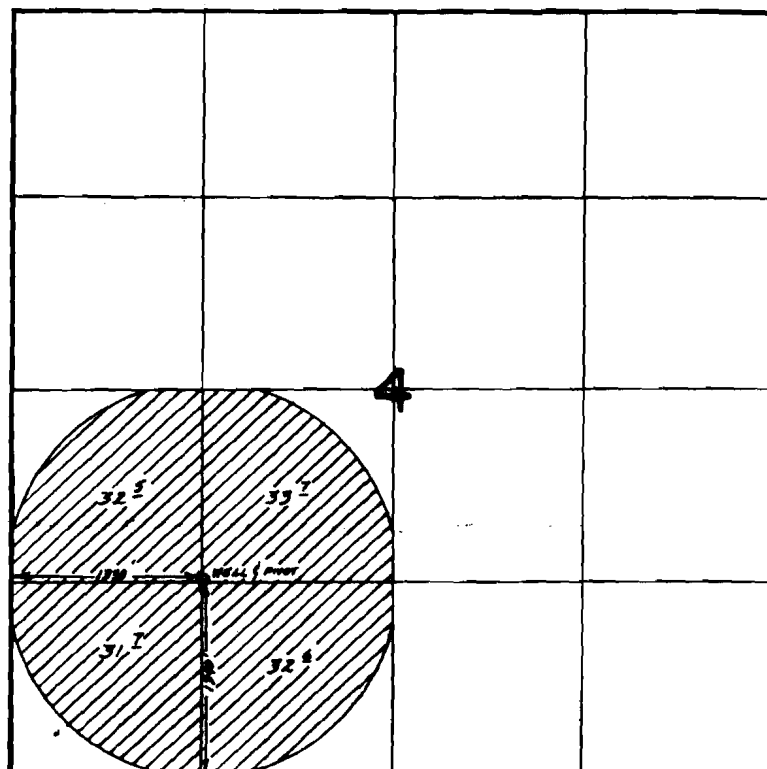

Scale: 1" = 1320'

FINAL PROOF SURVEY
UNDER

Application No. G:10923 Permit No. G:10035...
IN NAME OF

.....VERL E. NOFZIGER.....

Surveyed OCT. 25.. 1984., by B.W. BISHOP.....