


G 10235
53059

T.27S., R.16E., W.M.

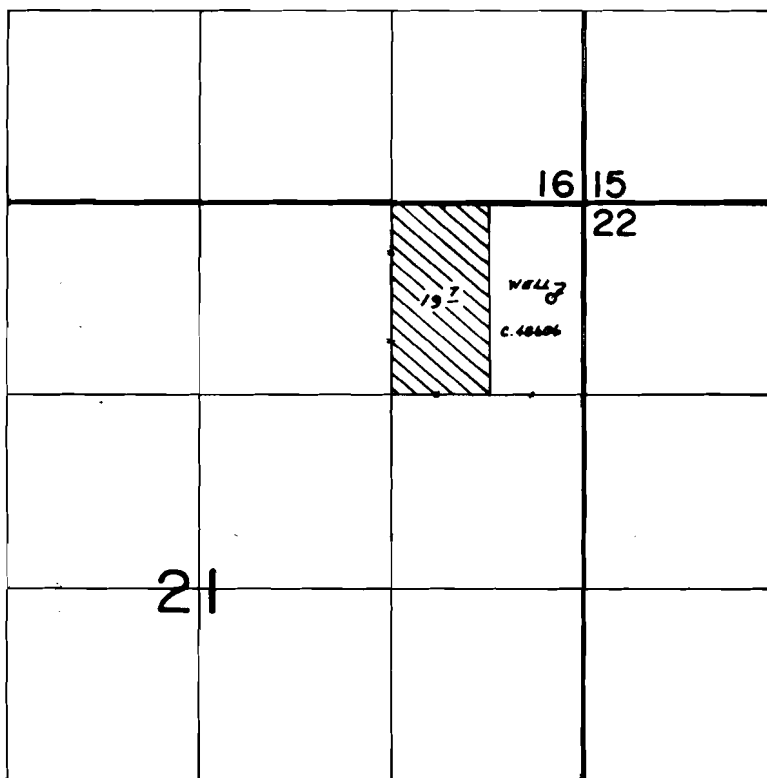

WELL LOC: 680 S. 830 W. FROM NE COR. SEC. 21

Scale: 1"=1320'

FINAL PROOF SURVEY
UNDER

Application No. G-11084. Permit No. G-10235.....
IN NAME OF

.....KENNETH E. POWELL.....

Surveyed OCT. 30.. 19.84., by B.W. BISHOP.....

9-15-83