


T. 20S. R. 3W.W.M.

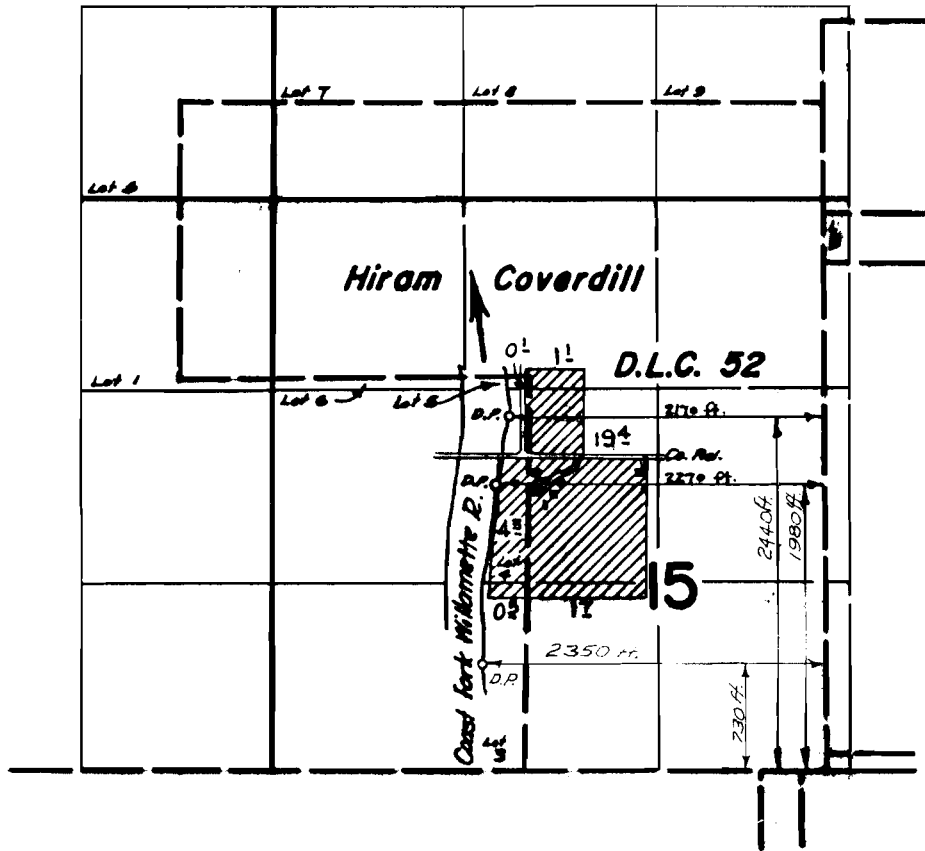

FINAL PROOF SURVEY

UNDER

Application No. 55530, Record No. 41848

By

KENNETH LAFON

on MAY 23 1979, by C. L. HUGHES