


T.20S. R.3W. W.M.

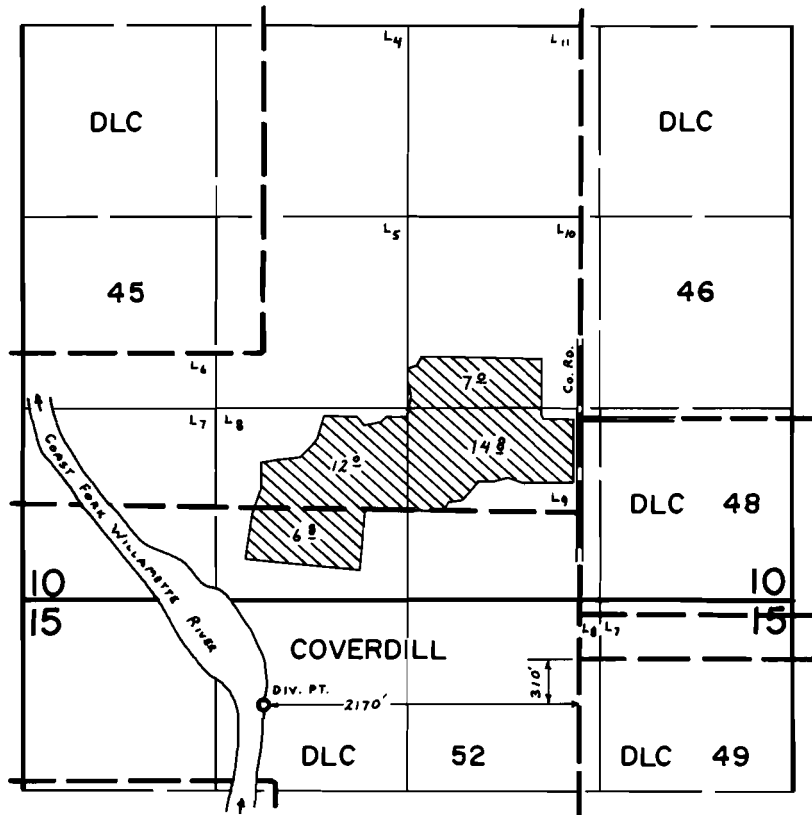

**FINAL PROOF SURVEY**  
UNDER

Application No. 55531 Permit No. 42525  
IN NAME OF

KENNETH LAFON

Surveyed May 23, 1979, by C. L. HUGHES