


T.16S.,R.7W.,W.M.

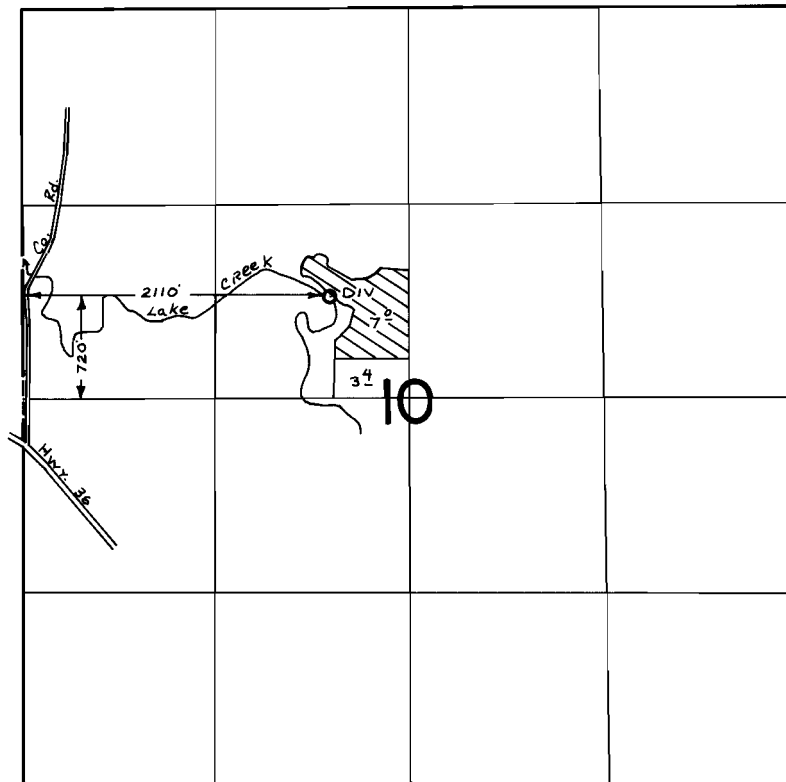

FINAL PROOF SURVEY
UNDER

Application No. 57115.... Permit No. 42975.....
IN NAME OF

J. EDWARD LARSEN

Surveyed Aug. 4, 1982, by L. M. TOLL.....