


T. 6S., R. 3W., W.M.

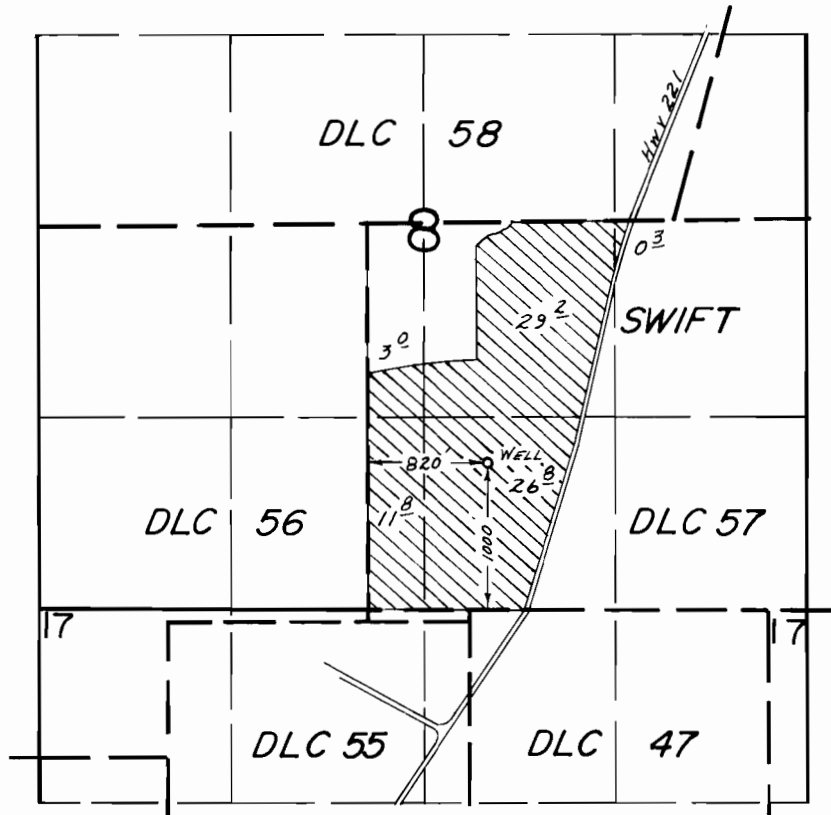

SCALE: 1" = 1320'

FINAL PROOF SURVEY
UNDER

Application No. G:6589. Permit No. G:6177.....
IN NAME OF

.....GARY DAUM.....

Surveyed May 15... 1979, by C.L. HUGHES.....