


T.4S. R.1W. W.M.

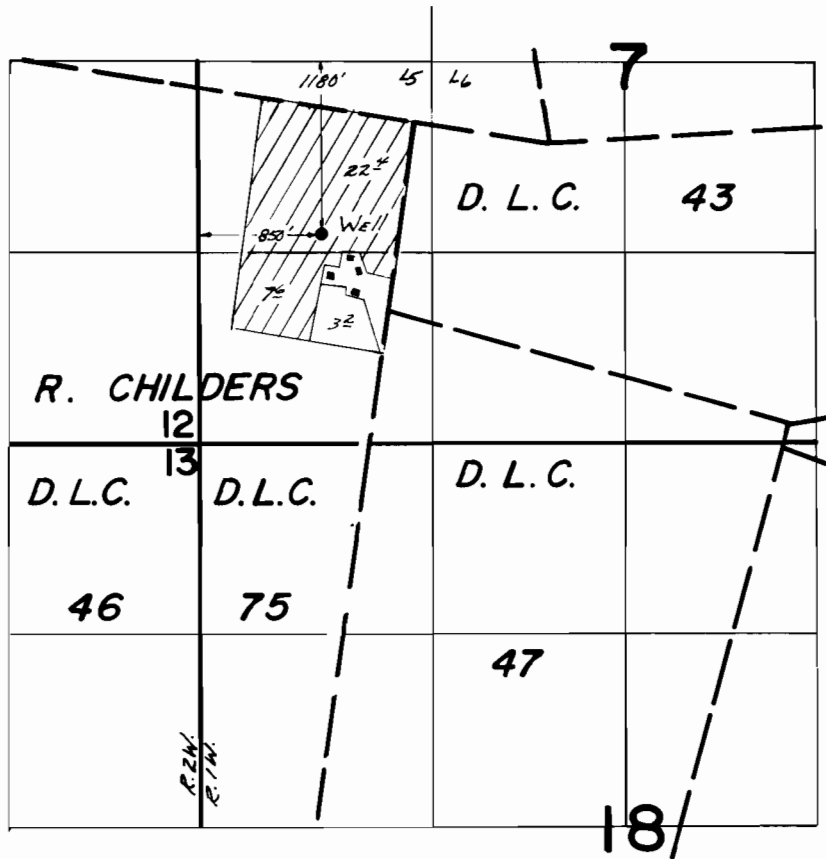

FINAL PROOF SURVEY UNDER

Application No. G-6883 Permit No. G-6414...
IN NAME OF

OLE R. STORMO

Surveyed Oct. 17, 1979, by C.R. RODRIGUEZ.