


T8S R2W WM

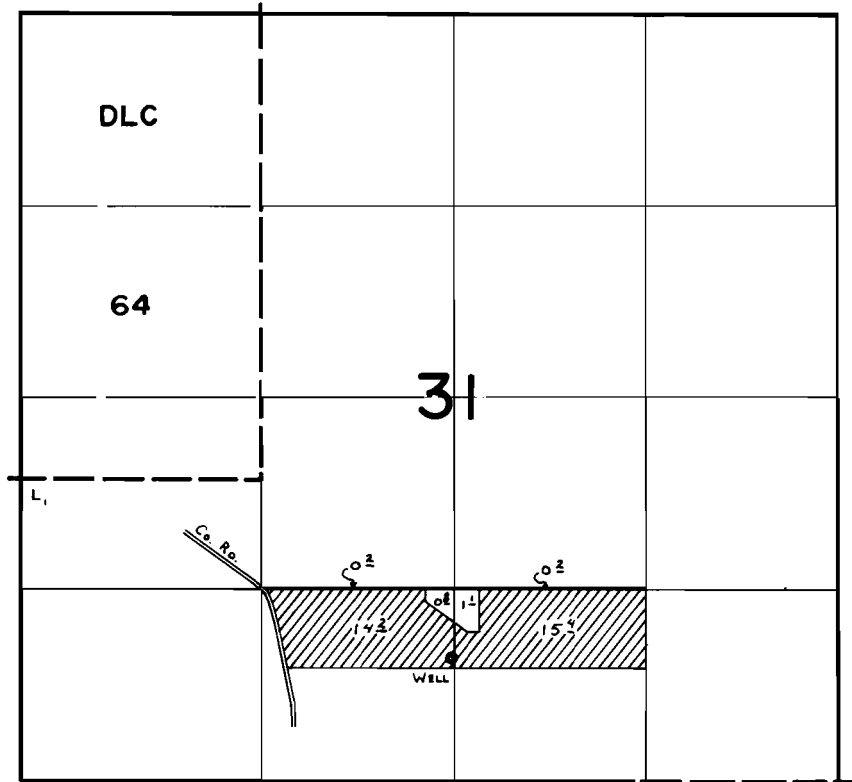

WELL LOC: 850' N. & 20' W. fr. S. 1/4 COR. SEC. 31.

FINAL PROOF SURVEY UNDER

Application No. **G-7681** Permit No. **G-7110**.....
IN NAME OF

JAMES M. HEIN

Surveyed **Apr. 22**..... 19**.80.**, by **C. L. HUGHES**.....