


T. 6 S., R. 1 W., W.M.

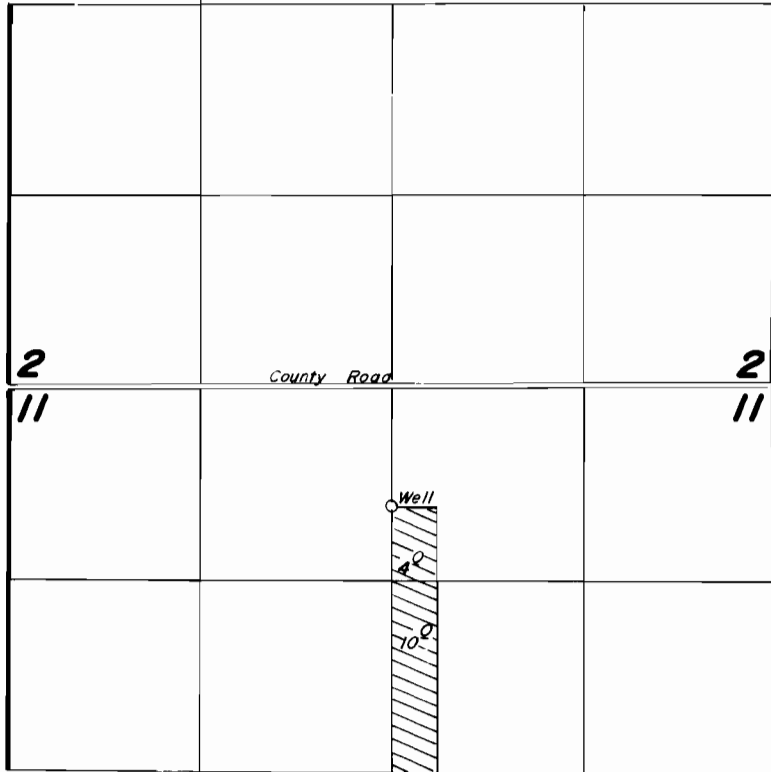

Well Loc: 820' S. & 20' E. from N. 1/4 Cor. Sec. 11.

1" = 1320'

## FINAL PROOF SURVEY

UNDER

Application No. *G-11235*.. Permit No. *G-10358*..  
IN NAME OF

***DICKMAN FARMS, INC.***

Surveyed *OCT. 1*.... 19*84*, by *Ben. Bishop*.....