


# T.4 N. R. 25 E. W.M.

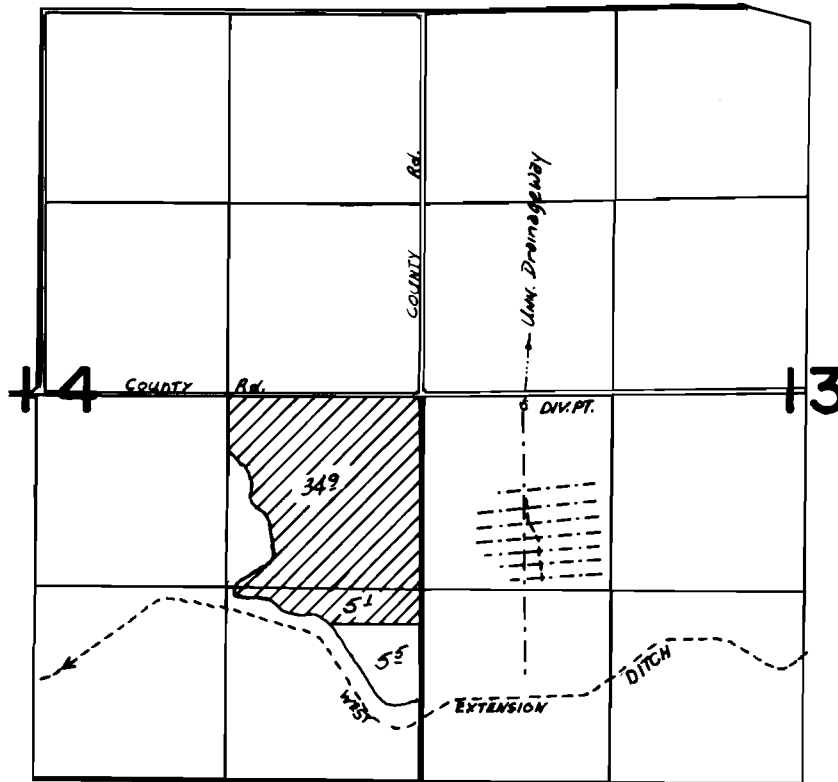

DIV. PT. LOCATED 50' SOUTH AND 700' EAST  
FROM 1/4 COR. 14+13

## FINAL PROOF SURVEY UNDER

Application No. **54163** Permit No. **41308**  
IN NAME OF

**GRIEB FARMS INC.**

Surveyed **Oct. 18** 19**83**, by **V.L. Church**