


T. 8S., R. 6W., W.M.

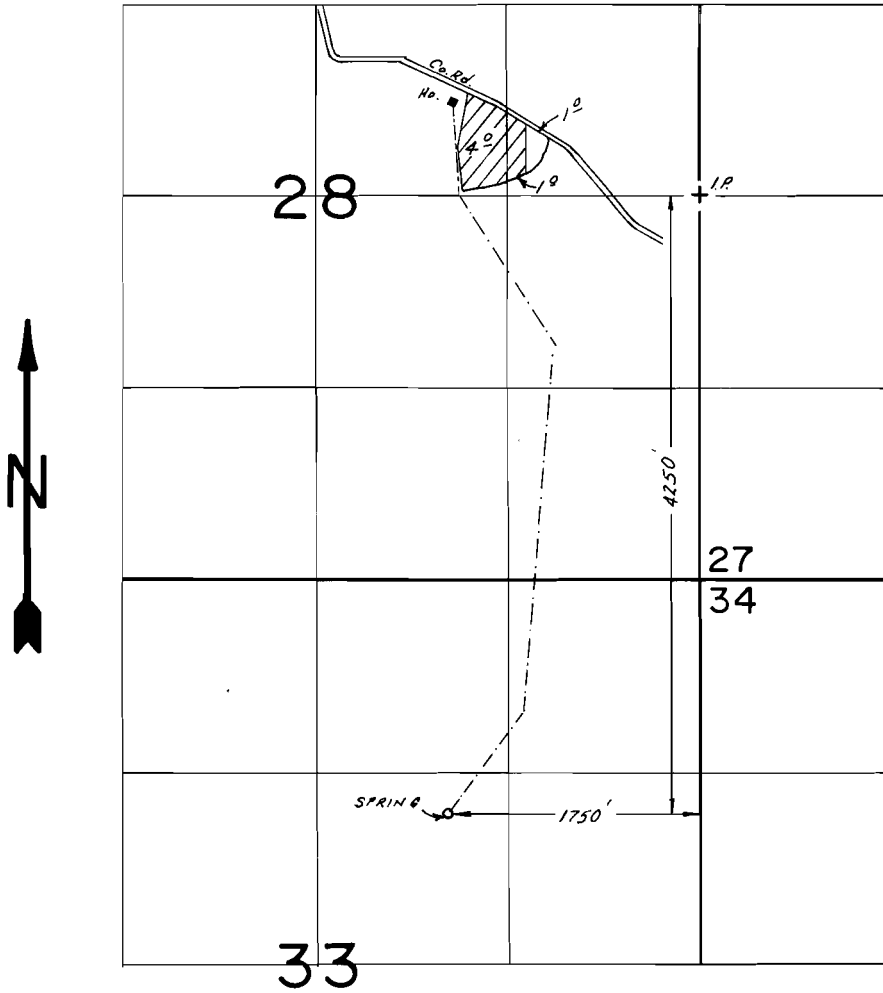

SCALE: 1" = 1320'

FINAL PROOF SURVEY
UNDER

Application No. 50609. Permit No. 38244.....
IN NAME OF

PHILLIP M. & CAROL N. JONES.....

Surveyed ..AUG. 5... 1983, by L.M. TOLL.....