


T. 2N. R. 33E. W.M.

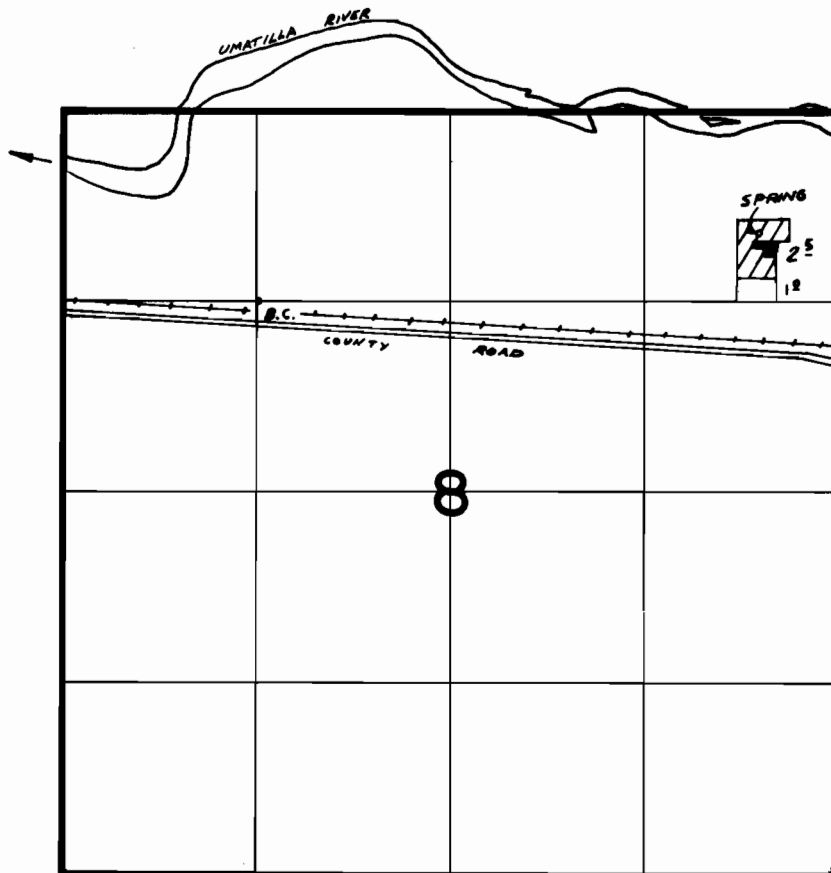

SPRING LOCATED 810'S & 550'W FROM NE COR SEC 8

FINAL PROOF SURVEY
UNDER

Application No. 51519..... Permit No. 38879.....
IN NAME OF

.....WARREN R. MILLER.....

Surveyed J-31..... 1979, by V. CHURCH.....