


T. 2N. R. 33E. W.M.

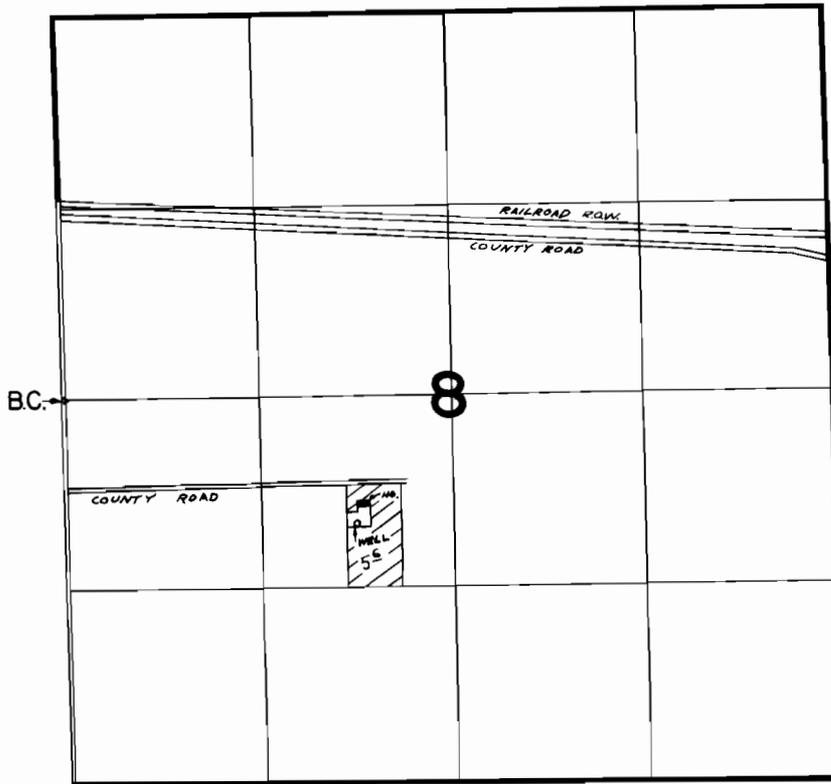

WELL LOCATED 660'W & 870'S FROM CENTER OF SEC 8

FINAL PROOF SURVEY
UNDER

Application No. G-6839 Permit No. G-6085
IN NAME OF

.....**ROBERT L. FETSCH**.....

Surveyed 6-22-1978, by B. BARWIN.....