


T. 2N., R. 33E., W.M.

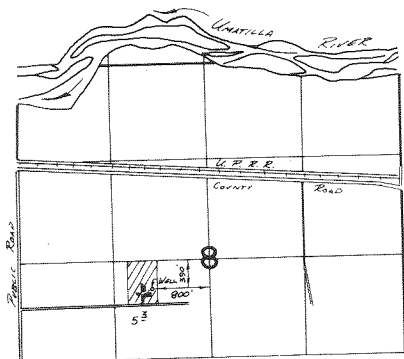

FINAL PROOF SURVEY
UNDER

Application No. G:7292 Permit No. G-6717
IN NAME OF

..... KENNETH DALE EDWARDS

Surveyed Aug. 4, 1982, by V.L. CAVESK