


G.7041
53078

T. 3N. R. 29E. W.M.

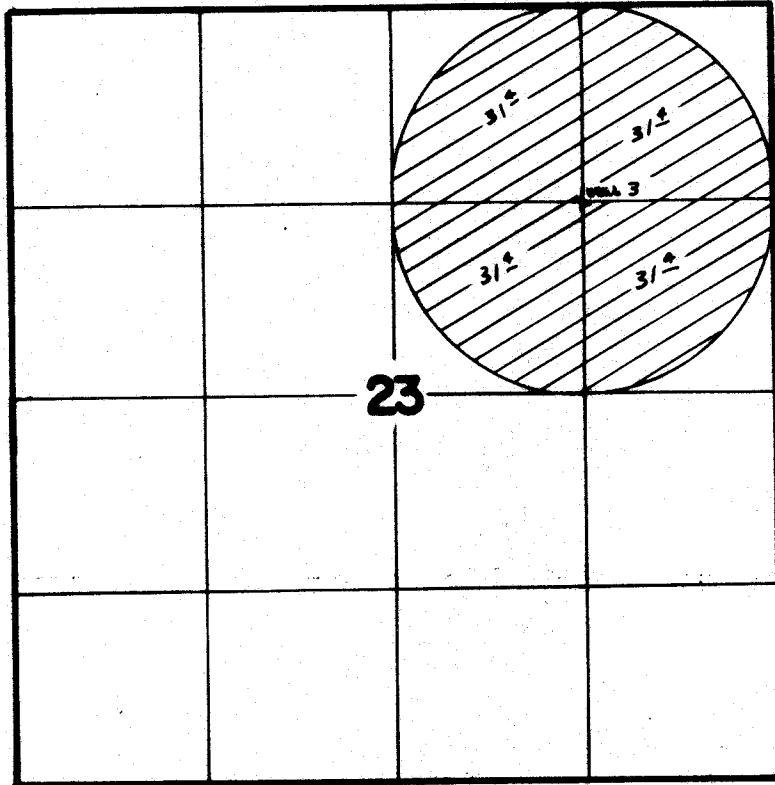

WELL LOCATED 396'N & 132'W FROM SE COR. SEC. 23

FINAL PROOF SURVEY
UNDER

Application No. G-7606... Permit No. G-7041...
IN NAME OF

.....**KENNETH H. COPPINGER**.....

Surveyed 5-2..... 1978, by R. BARWIN.....