


53082

T. 3N.,  
R. 29E.,  
W.M.

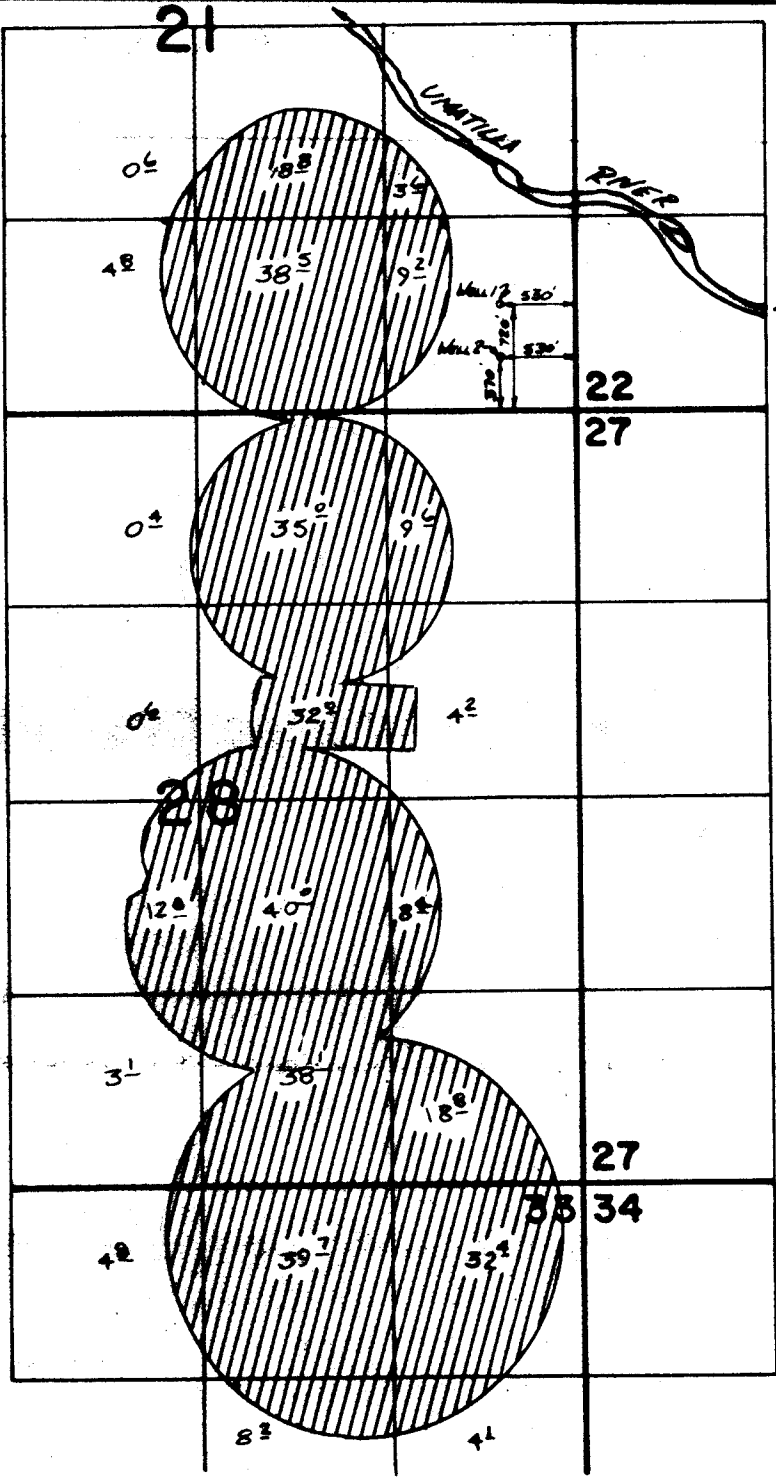

SCALE 1"=1320'

**FINAL PROOF SURVEY**  
**UNDER**

Application No. G-8976. Permit No. G-8369  
IN NAME OF

RON HOLEMAN

Surveyed 7-28 1982 by *L.H. Chumley*