


G9808  
33084

T. 6N., R. 35E., W. M.

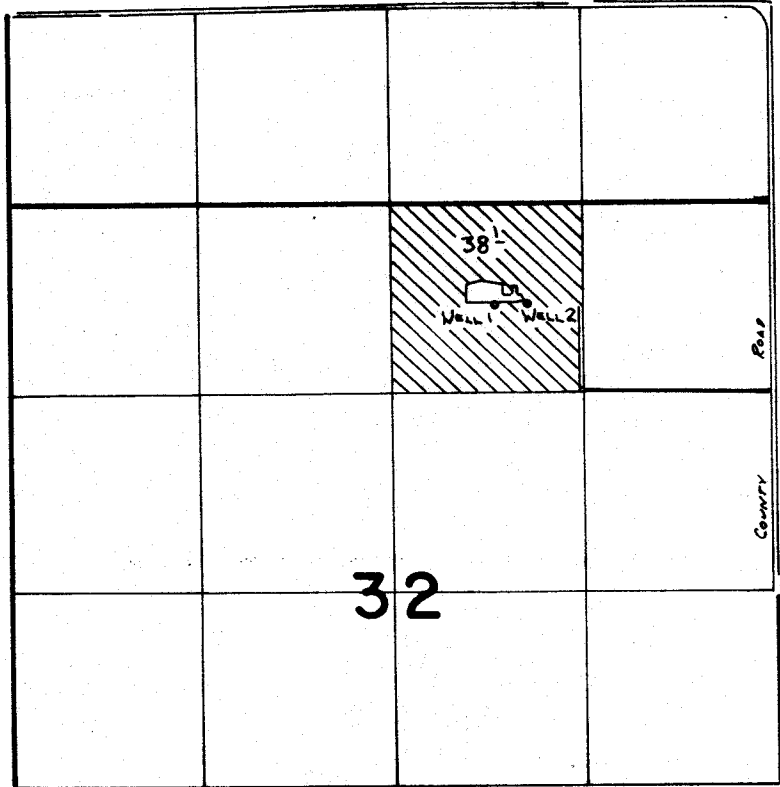

WELL 1 LOC: 700'S. & 710'E. FROM N<sup>1</sup>/<sub>4</sub> COR. SECTION 32  
 WELL 2 LOC: 680'S. & 940'E. FROM N<sup>1</sup>/<sub>4</sub> COR. SECTION 32

SCALE 4" = 1 MILE

**FINAL PROOF SURVEY**  
UNDER

Application No. G:10556 Permit No. G:9808..  
IN NAME OF

**KENNETH D. & BETTY E. PROCK..**

Surveyed ...4-13..... 1984., by K.L. Church.....