


T. 2N., R. 2W., W.M.

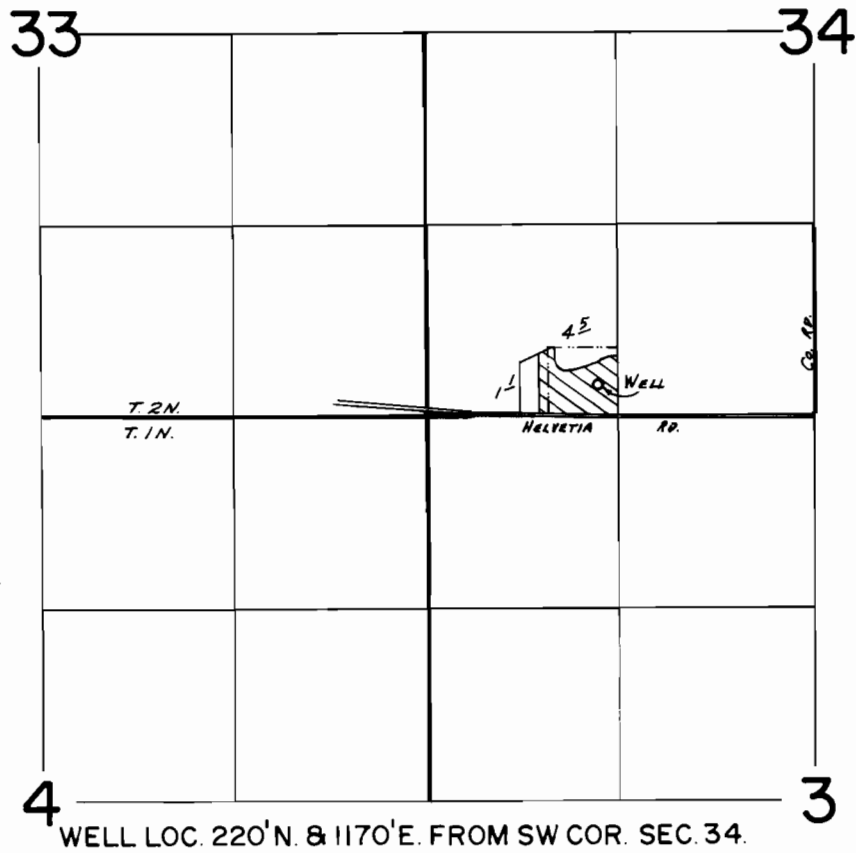

WELL LOC. 220' N. & 1170' E. FROM SW COR. SEC. 34.

FINAL PROOF SURVEY
UNDER

Application No. G-8285 Permit No. G-7669
IN NAME OF

ROBERT J. & BEVERLY F. YUNGEN

Surveyed JULY 23, 1980, by R.G. MUCKEN