


T.5S., R.6W., W.M.

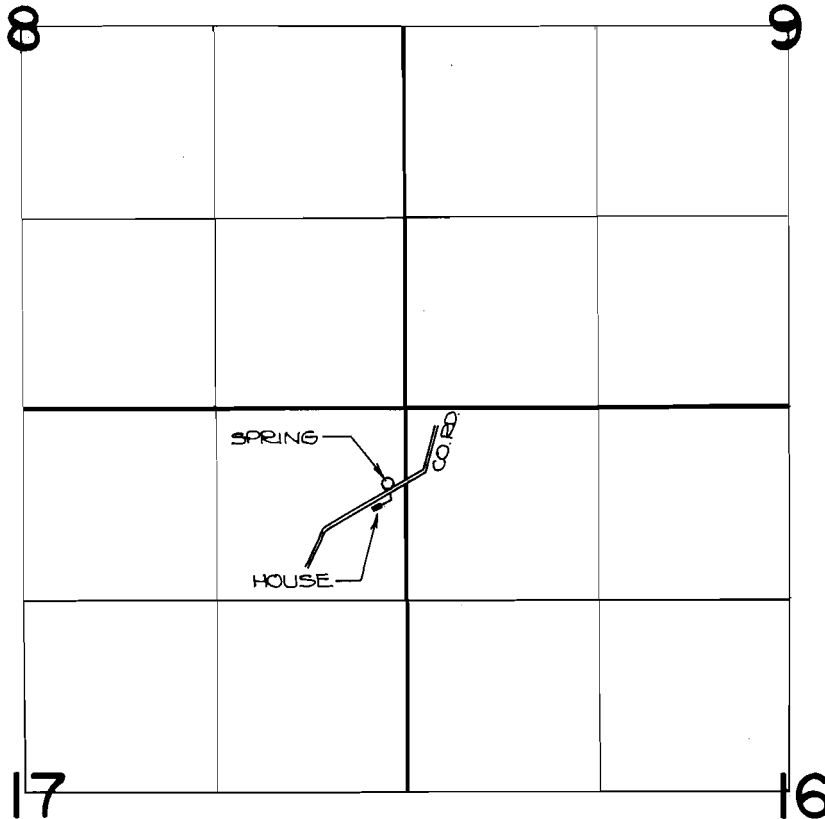

SPRING LOCATION: 540 FT. S. AND 100 FT. W. FROM
THE N.E. CORNER OF SECTION 17.

FINAL PROOF SURVEY
UNDER



SCALE: 4" = 1 MILE

Application No. 61700... Permit No. 46225...
IN NAME OF

..... **BILLIE L. KARLIN**

Surveyed NOV...1,.... 1984., by *P. Pagten*.....