


T. 5S., R. 5W., W. M.

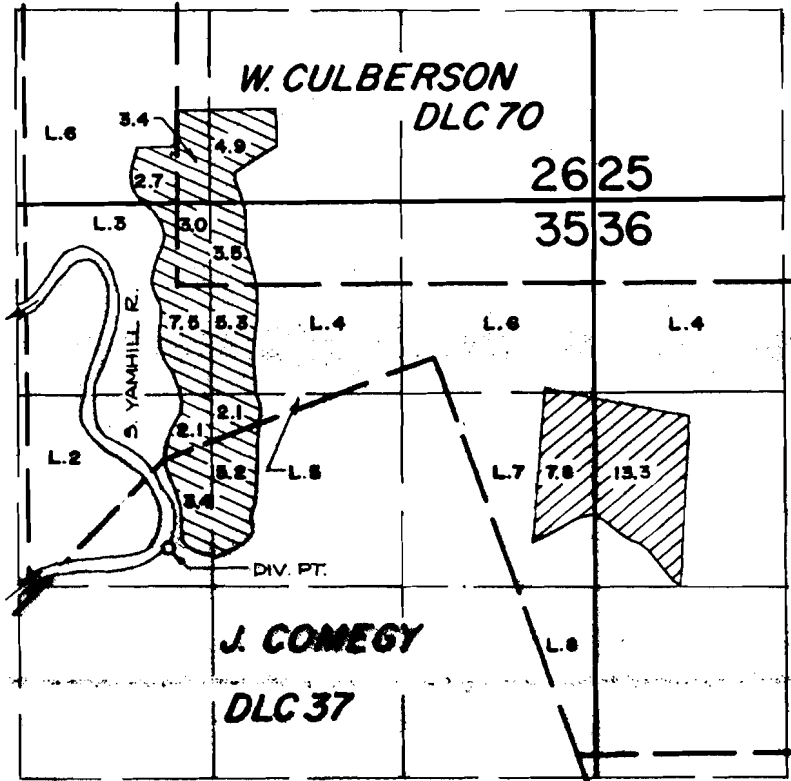

DIV. PT. IS LOCATED 2360 FT. S. AND 2930 FT. W.
FROM THE N.E. CORNER OF SECTION 35.

 PERMIT NO. 46660

 PERMIT NO. 45353

N

SCALE: 4" = 1 MILE

FINAL PROOF SURVEY UNDER

63113 46660
Application No. 60790 Permit No. 45353
IN NAME OF

.....R. L. WALKER FARMS, INC.....

Surveyed OCT. 3, 1984, by P. P. P. P.