


# T.4S., R.3W., W.M.

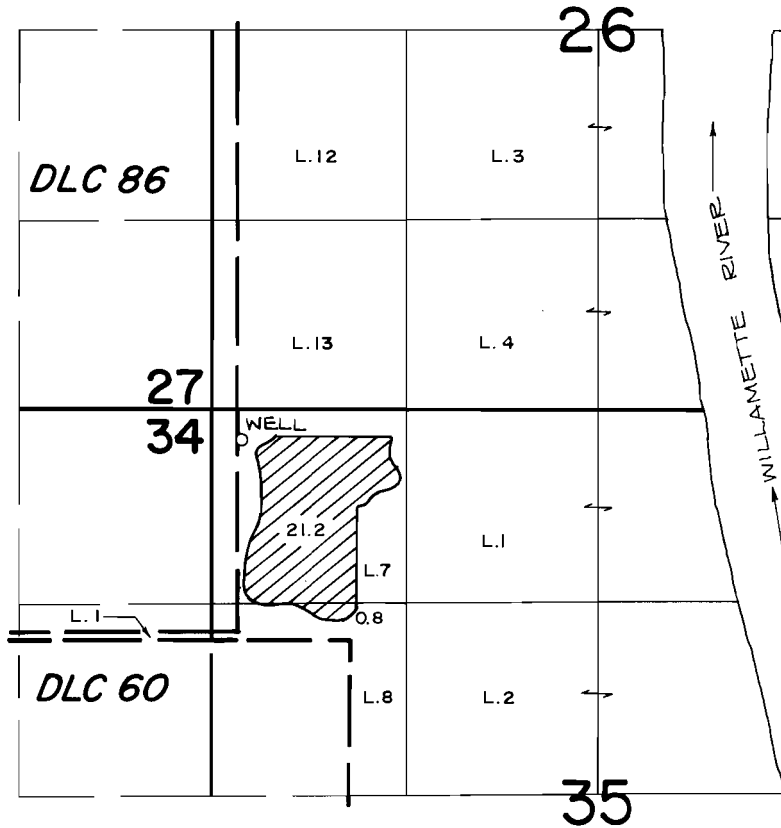

WELL LOCATION: 210 FT. S. AND 210 FT. E. FROM THE N.W. CORNER OF SECTION 35.

## FINAL PROOF SURVEY UNDER



SCALE: 4" = 1 MILE

Application No. G-7429 Permit No. G-6927  
IN NAME OF

ROBERT B. DORSEY

Surveyed MAY 15, 1984, by P. Patten