


Township 32 S

Range 2 E

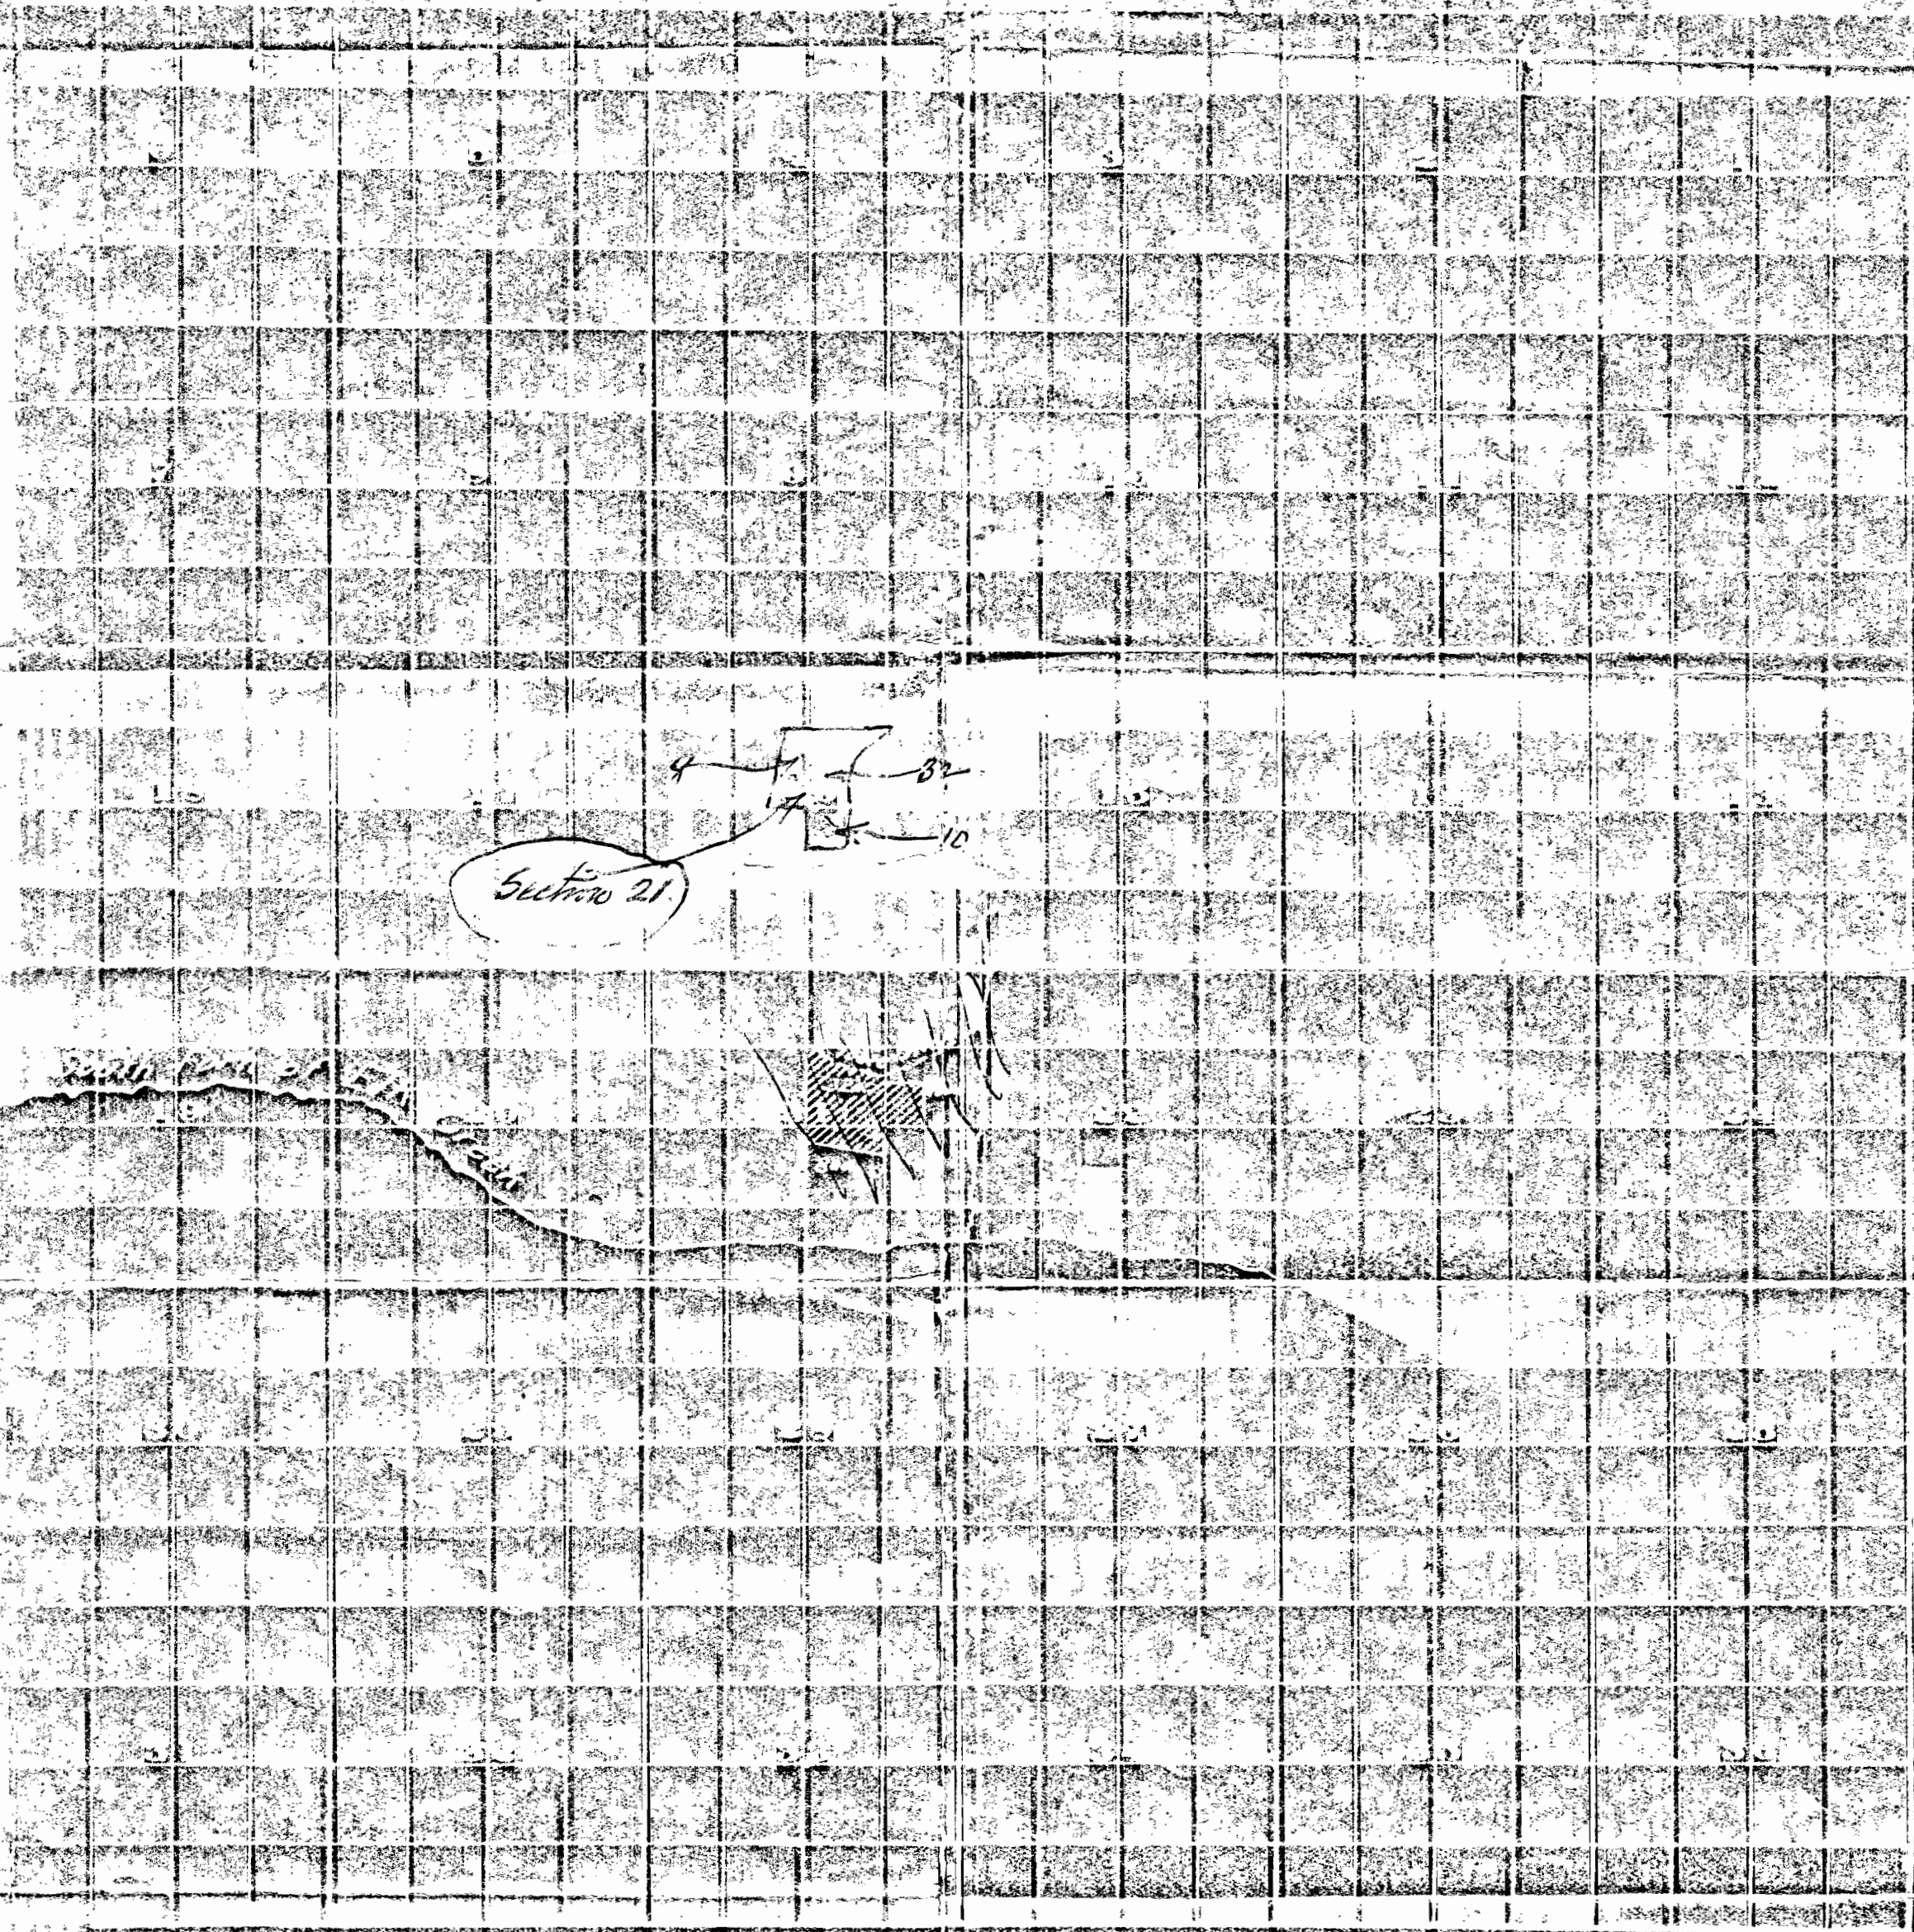

Section 21

Barber Creek


3734

7528

7528

Township 32 South; Range 2 East.

SALEM, OREGON
OCT 7 1914
RECEIVED
OFFICE OF STATE ENGINEER

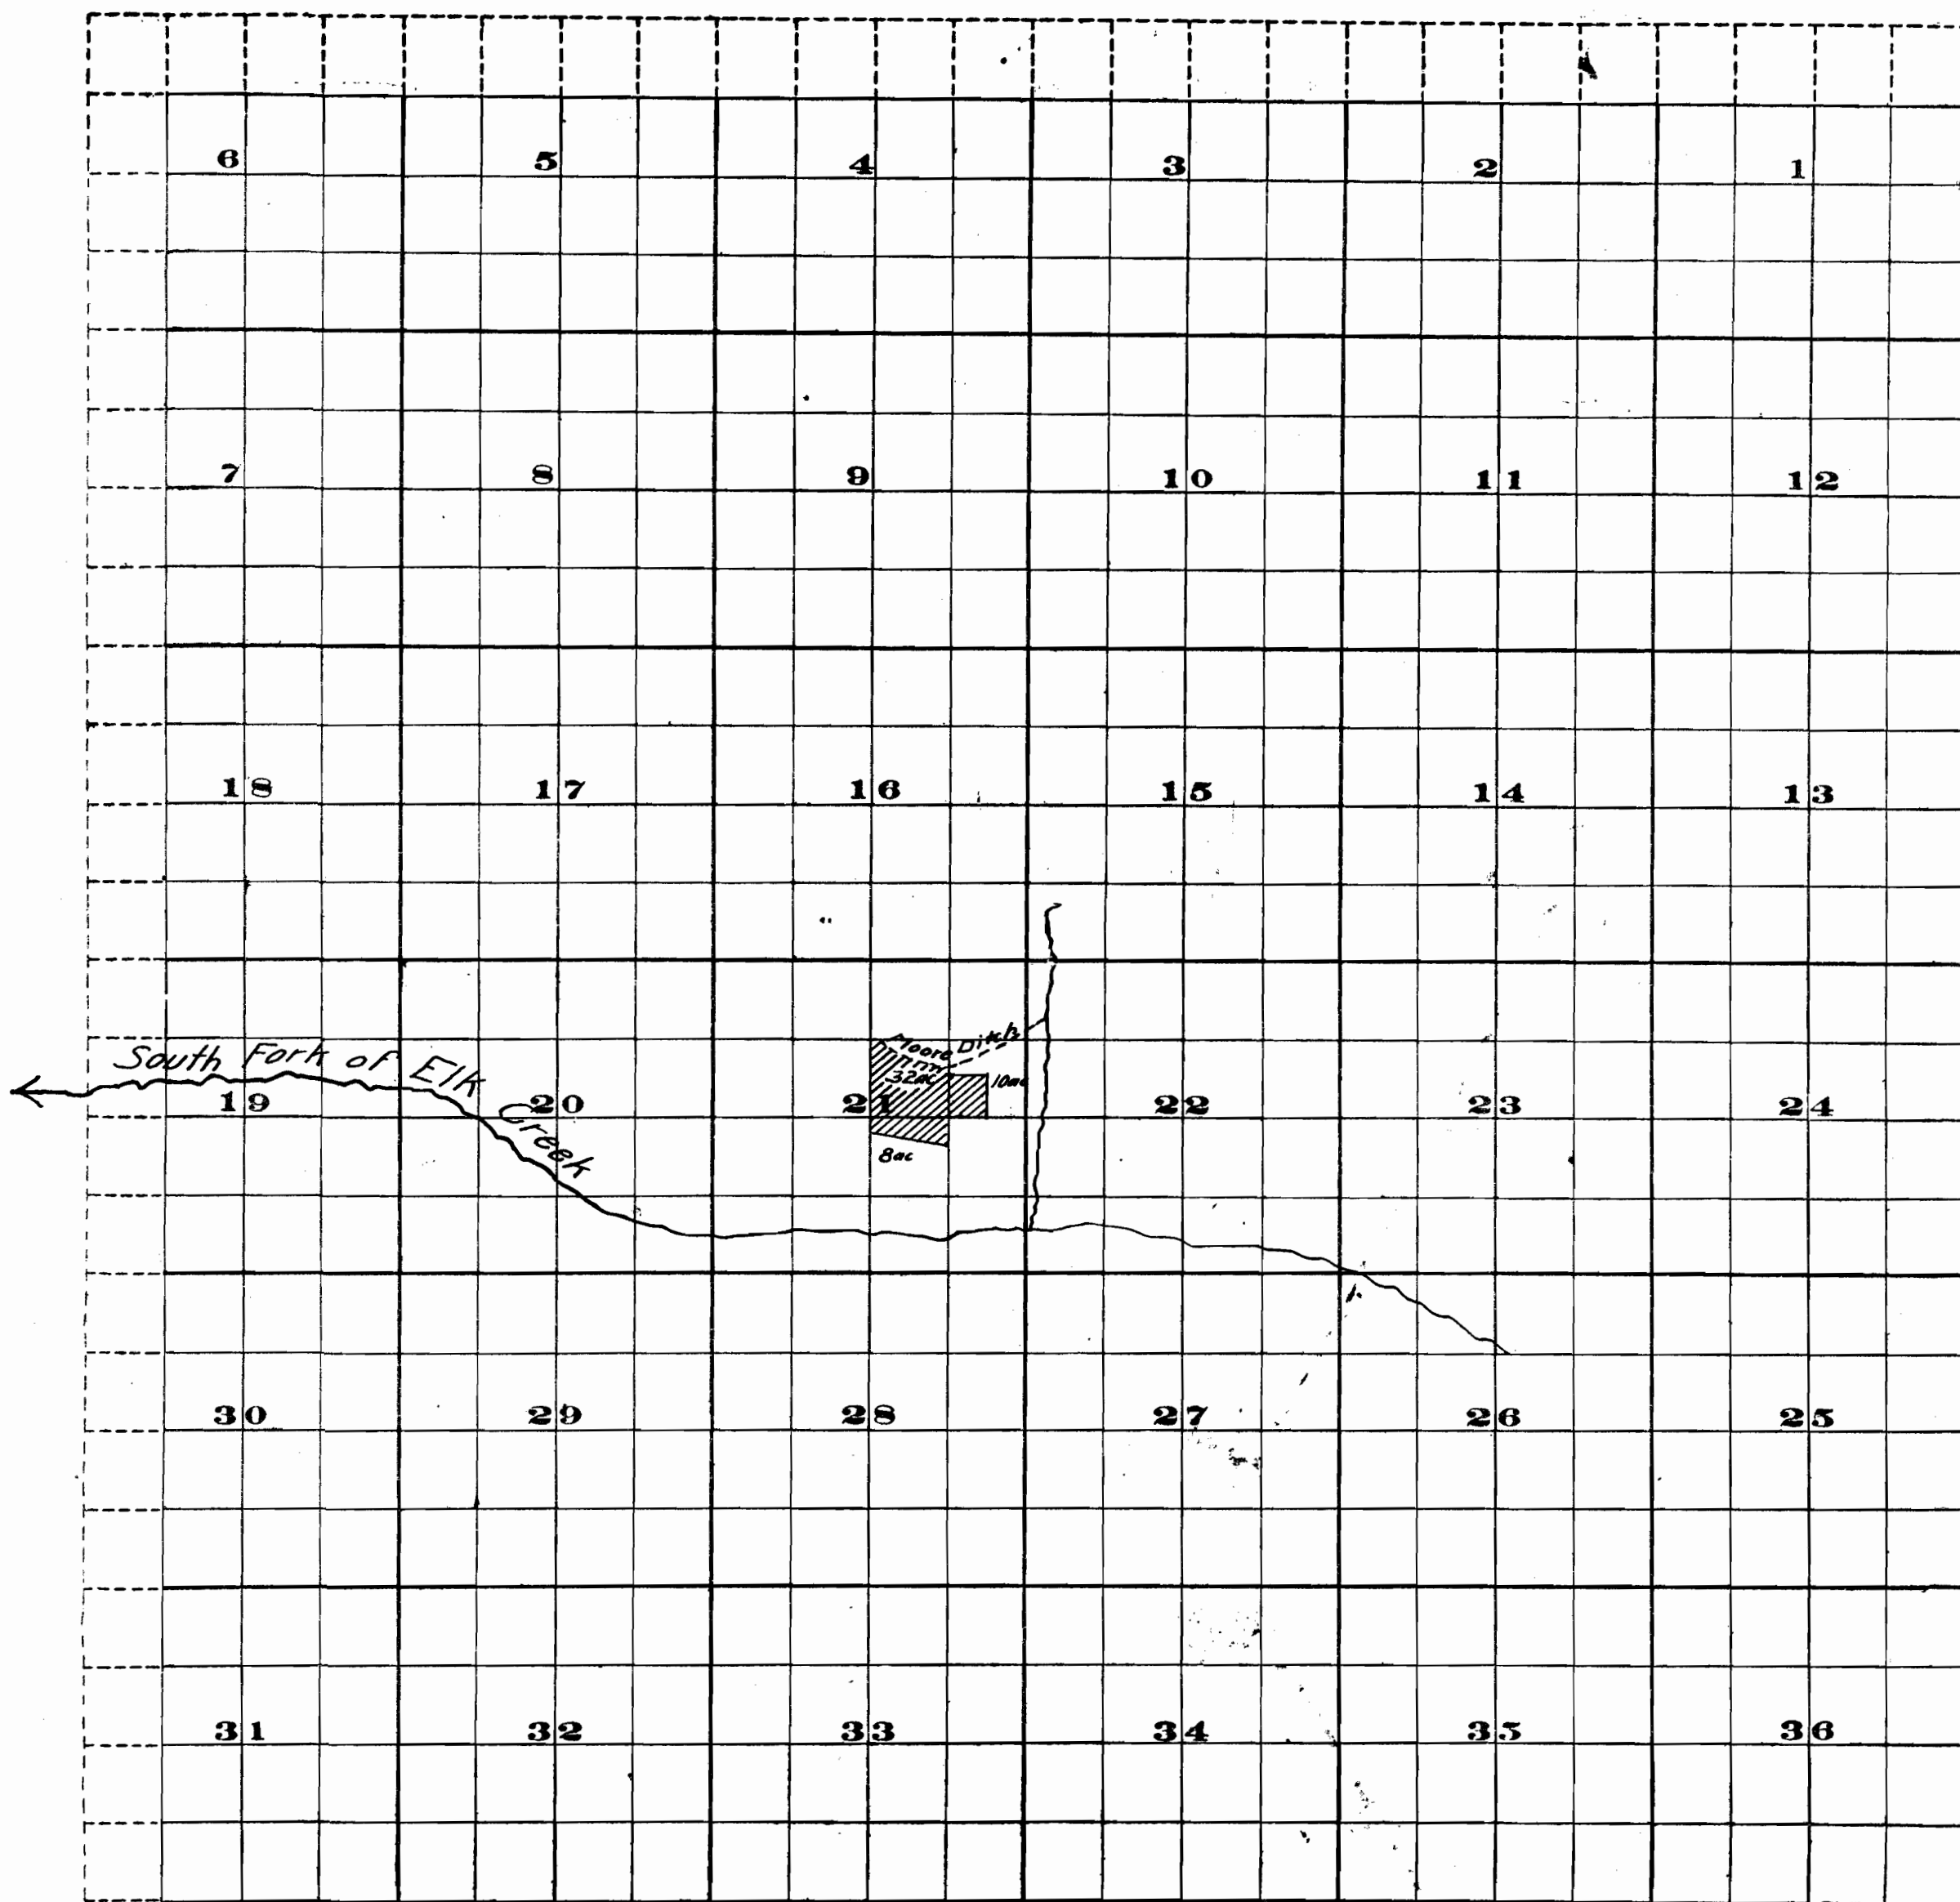

Scale of Feet

FROM OFFICE OF THE STATE ENGINEER, SALEM, OREGON

OFFICE OF STATE ENGINEER

RECEIVED

OCT 7 1914

SALEM, OREGON

Application No. 3924
Permit No. 2206

7528

Barry Shuart
Correction of POD location
Permit 2206, Certificate 5310
T32S, R2E, Sec 21 & 22

RECEIVED

OCT 15 2009

WATER RESOURCES DEPT
SALEM, OREGON

