


T. 8 & 9 S., R. 1 W., W.M.

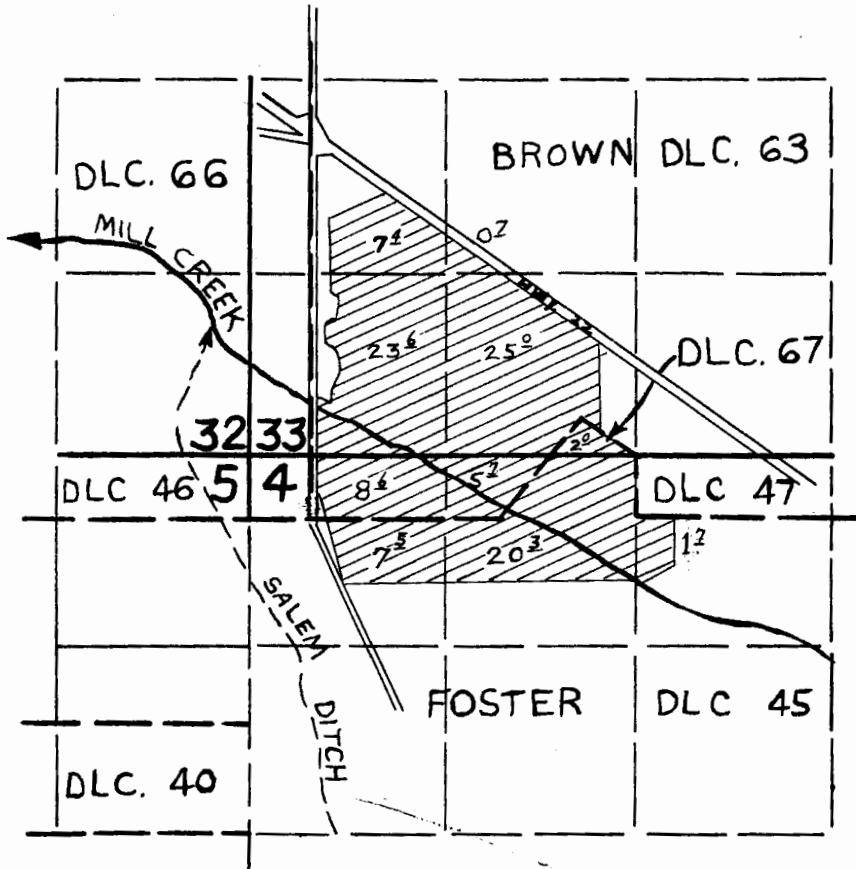

FINAL PROOF SURVEY

UNDER

Application No. 1508... Permit No. 1401...

IN NAME OF

SANTIAM GOLF CLUB, INC.

Surveyed May 30 1978, by L. NUNN
MAY 17, 1985 T. WARREN

REV. 5/30/85
TW

JC & MW