
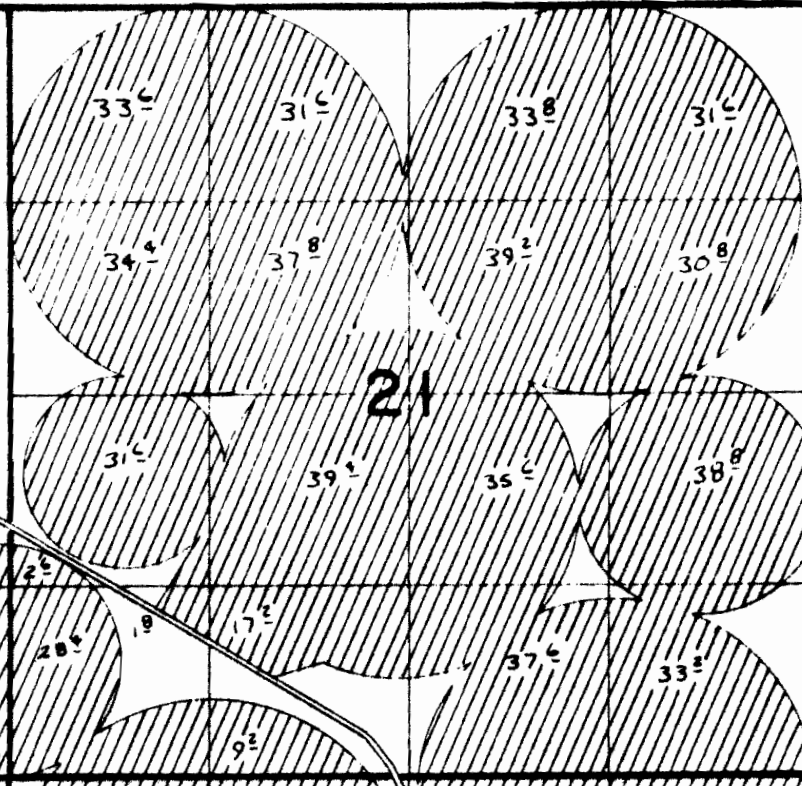


To Tom J.

T. 5N., R. 30E., W.M.

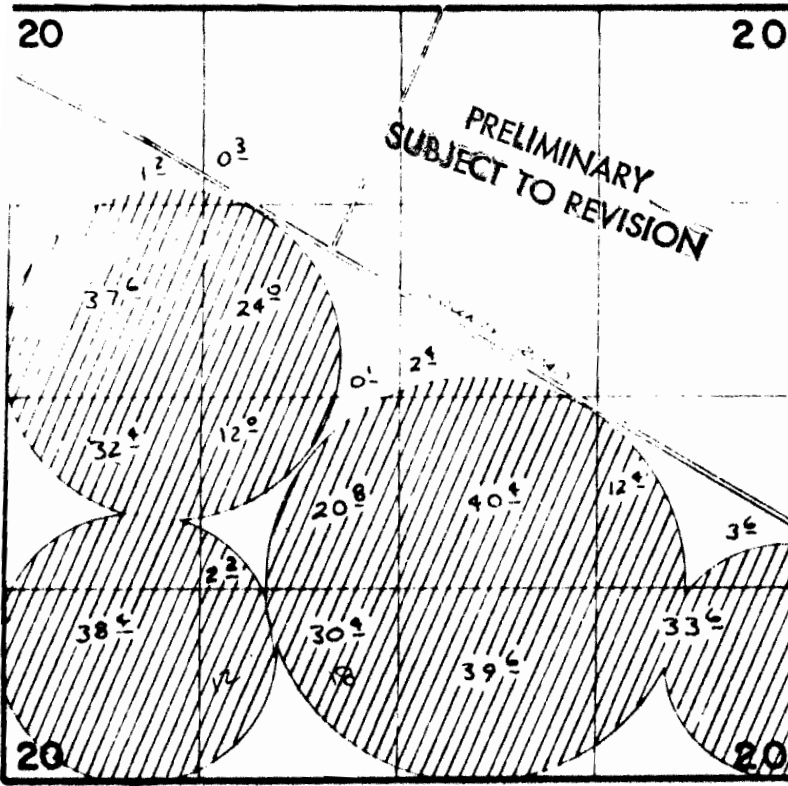

T. 5N. R. 30E. W.M.

PRELIMINARY
SUBJECT TO REVISION

Columbia River


DIV. PT.

2920'

150'

PRELIMINARY
SUBJECT TO REVISION

7 8

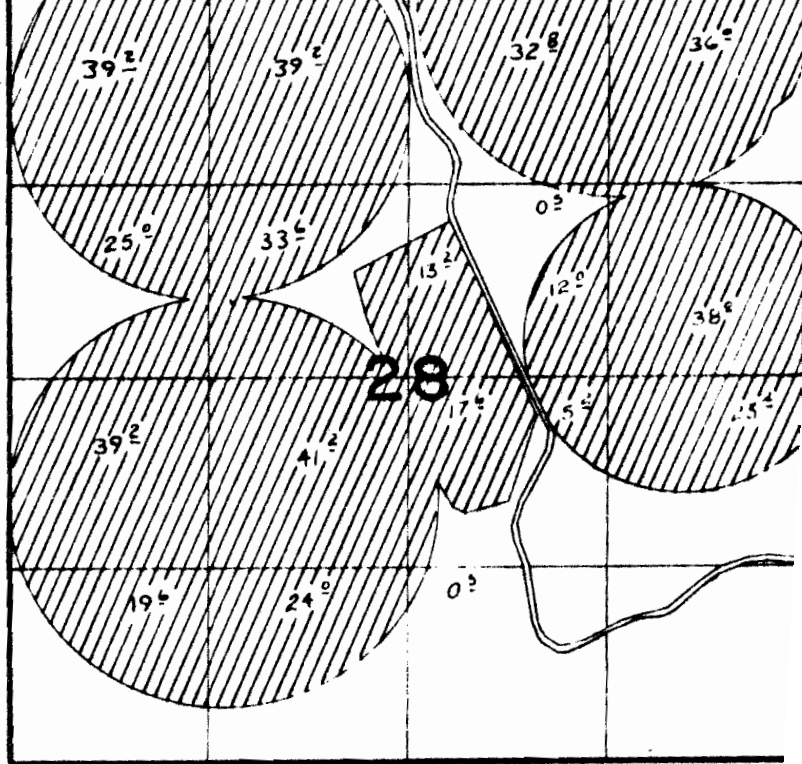

PRELIMINARY
SUBJECT TO REVISION

PRELIMINARY
SUBJECT TO REVISION

PRELIMINARY
SUBJECT TO REVISION

PRELIMINARY
SUBJECT TO REVISION

FINAL PROOF SURVEY UNDER

APPL. 47423

PER. 35522

IN NAME OF

MUTUAL LIFE INS. CO. OF NEW YORK

SURVEYED 2-16-79 BY R. BARWIN