


T. 7S., R. 39 & 40E., W.M.

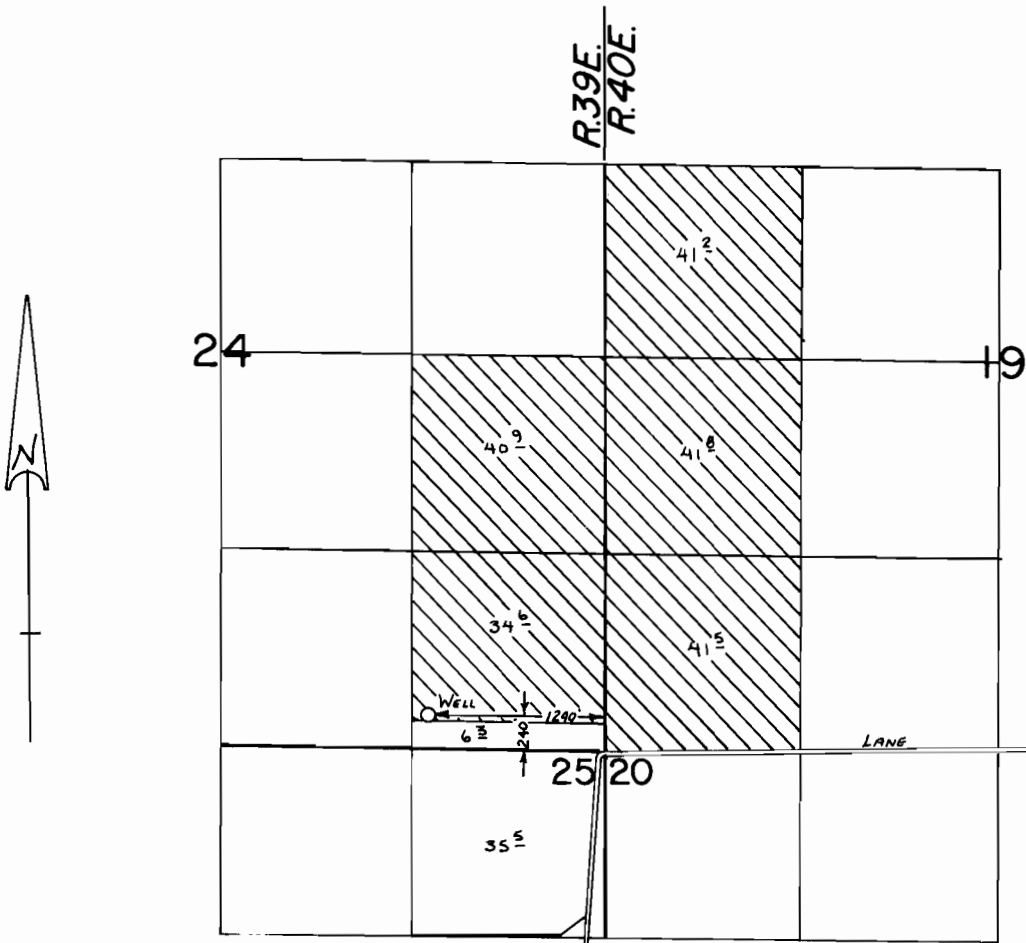

SCALE: 1" = 1320'

FINAL PROOF SURVEY
UNDER

Application No. G:8721.. Permit No. G:8094...
IN NAME OF

.....FRASER RANCHES.....

Surveyed May...21... 1984., by V.L. CHURCH.....