


T. 4 & 5 S., R. 1 E., W. M.

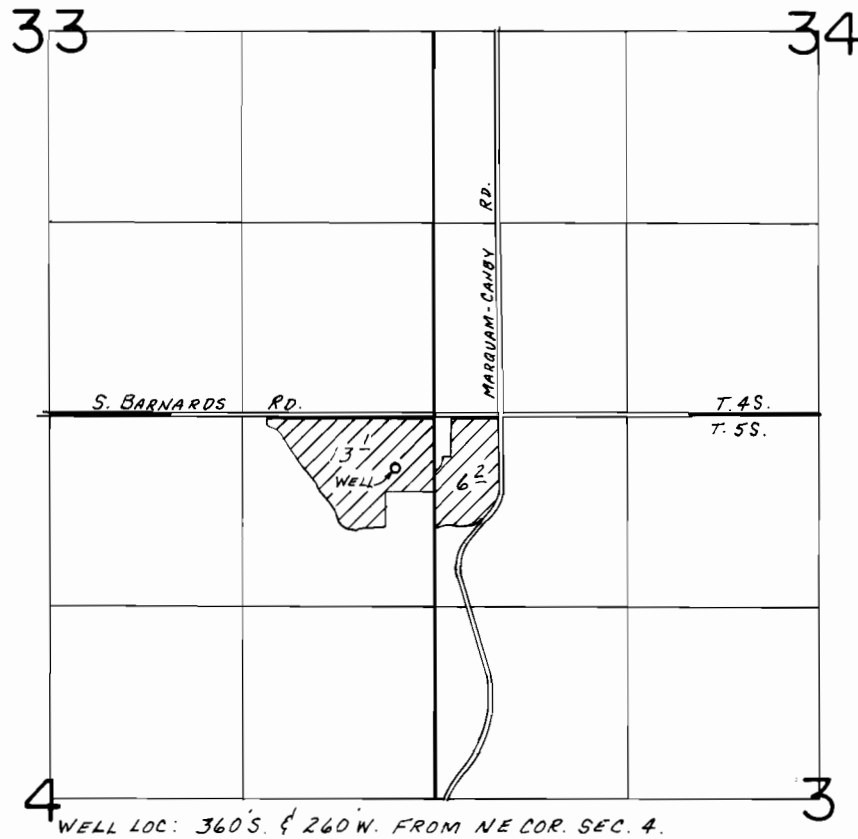

SCALE: 1"=1320'

FINAL PROOF SURVEY UNDER

Application No. G-9418.. Permit No. G-8752....
IN NAME OF

.....VERN. QULST.....

Surveyed Aug. 8..... 19.84, by J.R. WOODROOF.