


T. 28 S., R. 12 W., W.M.

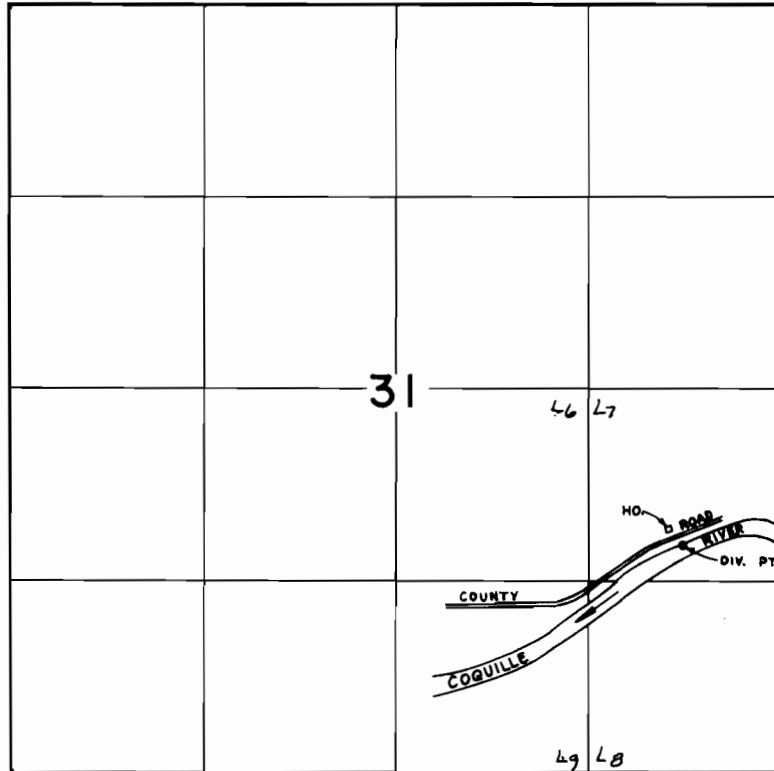

DIV. PT. LOCATED 1,075' S. & 675' W. FROM E. 1/4 CORNER SECTION 31

SCALE: 4" = 1 mile

FINAL PROOF SURVEY UNDER

Application No. 57802.. Permit No. 43752.....
IN NAME OF

NOLAN W. & CHARLOTTE A. GLAUNER

Surveyed OCT. 10, 1983, by L. CASHION..