


T. 26 S., R. 3 W., W. M.

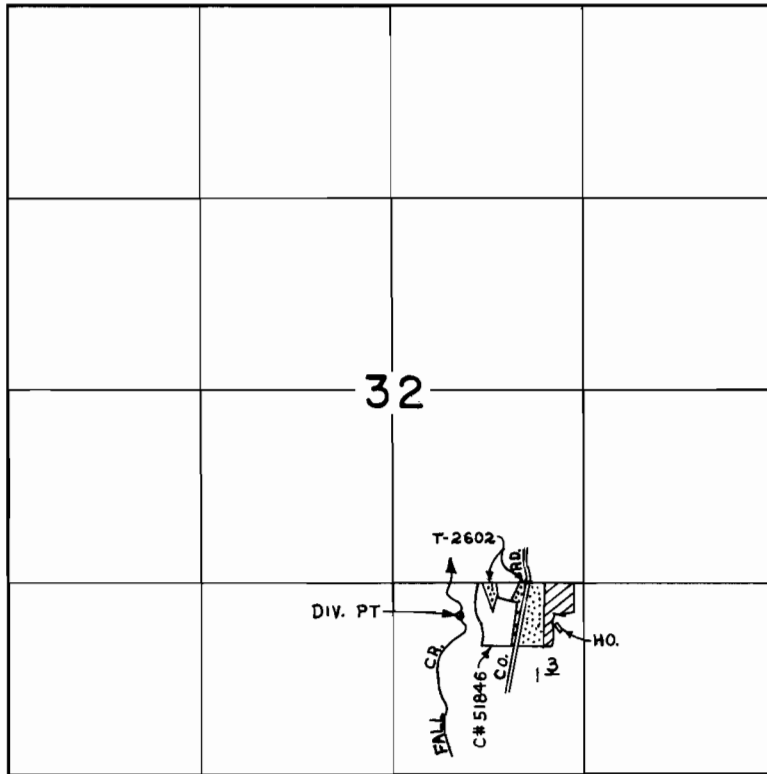

DIV. PT. LOCATED 225'S. & 460'E. FROM CS. 1/16 COR. SEC. 32

SCALE: 4" = 1 mile

FINAL PROOF SURVEY UNDER

Application No. 65533... Permit No. 47990.....
IN NAME OF

ALFRED J., JR. & NANCY GETTYS

Surveyed JUL 25, 1984, by L. CASHION...