




38225

sup 53136  
66223

T. 3N., R. 22E., W.M.

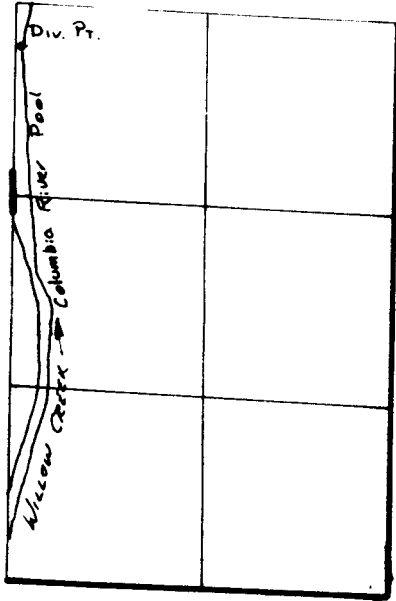

Div. Pt. Loc: 3690' N AND 260' W  
FROM SE COR. SEC. 1

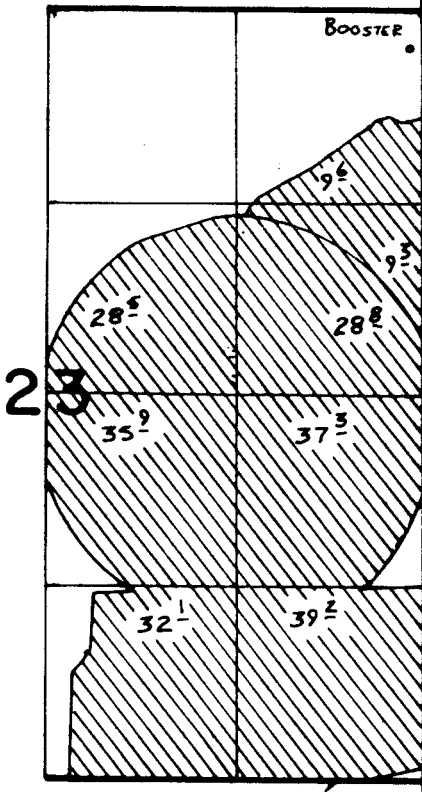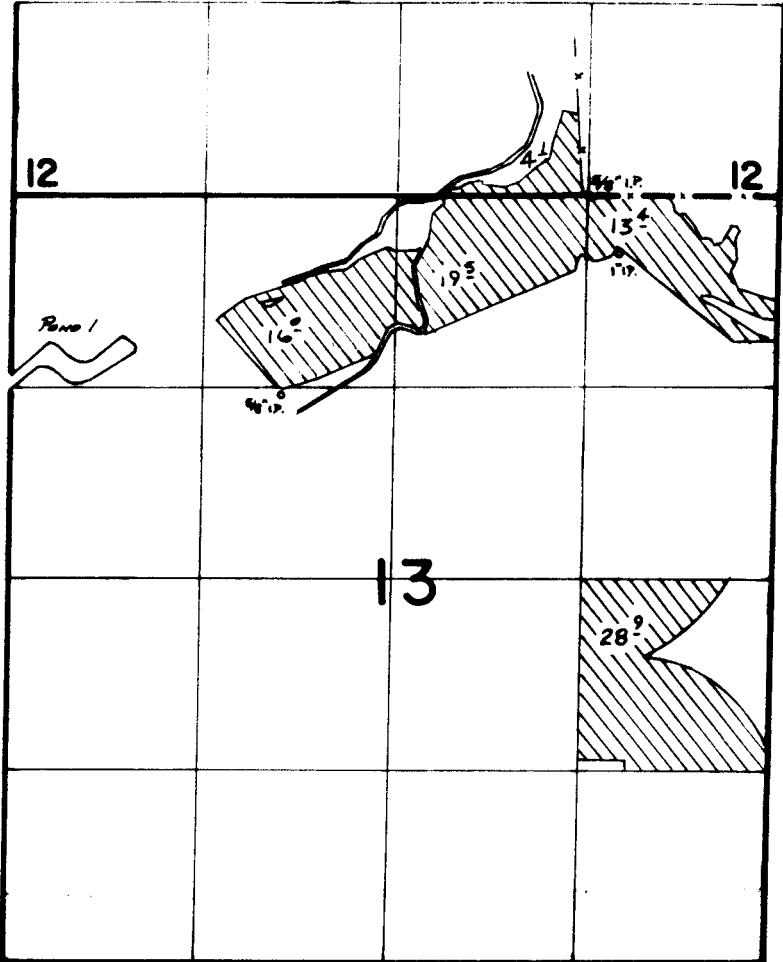

# FINAL PROOF SURVEY UNDER

APPL. 53497 PER. 38225  
IN NAME OF

ORIS & DORIS CRISP et al

SURVEYED Oct. 13, 1983. by *V.L. Church*

272-18  
378-144L  
775-1985-P-A 10/17/83