
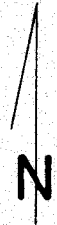


T.13S., R.26&27E., W.M.

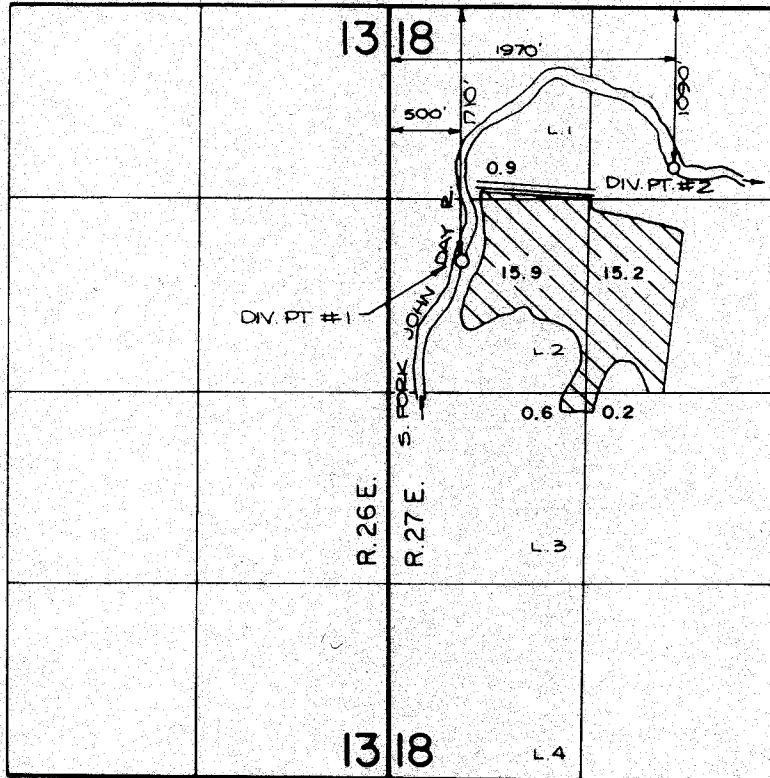

**FINAL PROOF SURVEY**  
 UNDER

SCALE: 4" = 1 MILE

Transfer No. 2979

Application No. 52138 Permit No. 37526

IN NAME OF

**JAMEY MAZZOTTA**

Surveyed AUG. 28, 1984, by S. BROWN